

\$7.00
\$2.00

SECURITY &
RECORDATION
FEB 6 8 1999

LAND CORNER RECORDATION CERTIFICATE
Filing Requirement of Act 74, Mich. P.A. 1970
KENT COUNTY REMONUMENTATION

For corners in

SECTION


Kent (County)	Located in:	Gratian Township	Corner Code #
1. Public Land Survey	T <u>8N</u>	R <u>9W</u>	<u>G-3</u>
	T _____	R _____	_____
	T _____	R _____	_____
	T _____	R _____	_____
2. Property Controlling in Section	S _____	T _____	R _____
	S _____	T _____	R _____
3. Miscellaneous Property in Sec.	S _____	T _____	R _____
	S _____	T _____	R _____

STATE OF MICHIGAN
COUNTY OF KENT
RECEIVED FOR RECORD
39 OCT 23 AM 9:59
REG. OF DEEDS
10868

Register of Deeds Stamp & File Number

4. Lot No. _____, Recorded Plat _____
5. Private Claims _____

I, Randy Kolehouse, in a field survey on March 13 19 98, do hereby certify that under requirements of P.A. 74 Michigan P.A. of 1970, the corner points mentioned in lines 1 and 2 above were in conformance with regulations and rules therefore as required in the current manual of survey instructions of the United States Department of the Interior, Bureau of Land Management or by a decree of a Court of Law and/or that the corner points mentioned in lines 3, 4 and 5 above were in conformance with the rules of the Michigan Board of Land Surveyors or by a Decree of a Court of Law; established, re-established, monumented, re-monumented, recovered, found as expressed below:

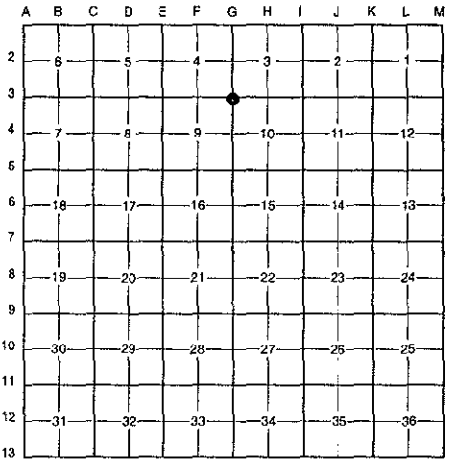

NOTE: Not more than 4 corners, all in the same town and range, may be recorded on this certificate.

A. Description of original monument and accessories and/or subsequent restoration:

G-3	1837	G.L.O. Notes	Cathcart	Set Post
	N/A	Witness Map	K.C. Surveyor	Iron
	1946-56	Notes	Williams & Works	Set Iron
	1984	L.C.R.C. #4140	C. Hay	Reset Rerod and Cap
	1985	L.C.R.C. #4183	R. Kolehouse	Fnd. Capped Iron / Set K.C. Monument
	1994	L.C.R.C. #8034	Glaza & Associates	K.C. Monument

P.A. 345 1990 KENT COUNTY
PEER APPROVED 6/25/98
CHAIRMAN Randy Kolehouse

This corner was originally approved by the Kent County Remonumentation Peer Group and monumented by R. Kolehouse and on 3/16/98 was recorded per L.C.R.C. #4183.

B. Description of corner evidence found and/or method applied in restoring or reestablishing corner:

G-3 Found a Standard Kent County Monument 100' ± South of C/L of cul-de-sac of Dream Isle Road (bit.), on line of a tree row running East and West, per L.C.R.C.'s #4183 and #8034 as set by Randy Kolehouse in place of a capped iron he found which checked L.C.R.C. #4140, notes of Williams & Works, and the K.C. Surveyor's records.

L.C.R.C. #4183

L.C.R.C. #8034

Nail & K.C. Remon. tag in S. side 6" Ash S 80° E 14.11'
Nail & K.C. Remon. tag in N. side 14" Ash S 45° E 21.30'
Nail & K.C. Remon. tag in W. side 10" Ash S 10° W 21.41'
Nail & K.C. Remon. tag in NW side 6" Ash S 45° W 32.23'
Conc. Monument S 88°30' W 66.00' (SW cor. Pine Island View Park)
North edge Swamp South 30' m/l


Nail & K.C. remon tag in S side 9" Ash S80°E 14.38' (m. 14.41')
Nail & K.C. remon tag in N side 16" Ash S45°E 21.24' (m. 21.32')
Nail & K.C. remon tag in W side 12" Ash S10°W 21.19' (m. 21.21')
Nail & K.C. remon tag in NW side 7" Ash S45°W 32.02' (m. 32.0')
Nail & K.C. remon tag in NE side 9" Ash S40°E 28.29' (m. 28.30')
North edge swamp South 30' m/l

The selected location is accepted by me and is generally accepted by professional surveyors as the best available evidence of the position of the original corner.

C. Description of monument for corner and accessories established to perpetuate locating the position of the corner:

G-3 Standard Kent County Monument

Nail & K.C. remon. tag on S side 9" Ash S 80° E 14.41'	C/L of cul-de-sac, North 100' ±
Nail & K.C. remon. tag on N side 16" Ash S 45° E 21.23'	On tree row running E-W
Nail & K.C. remon. tag on W side 12" Ash S 10° W 21.21'	
Nail & K.C. remon. tag on NW side 7" Ash S 45° W 32.0'	
Nail & K.C. remon. tag on NE side 9" Ash S 40° E 28.30'	

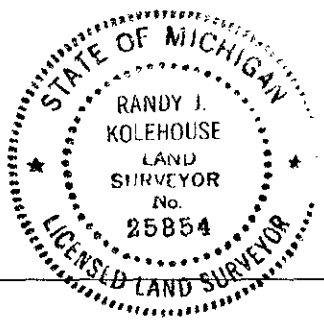

Signed by Randy J. Kolehouse
EARTH TECH

Date 9-1-98

Surveyor's Michigan License No. 25854