

\$7.00  
\$2.00

MAR 08 1999

**LAND CORNER RECORDATION CERTIFICATE**  
**Filing Requirement of Act 74, Mich. P.A. 1970**  
**KENT COUNTY REMONUMENTATION**

STATE OF MICHIGAN  
 COUNTY OF KENT  
 RECEIVED FOR RECORD  
 98 OCT 23 AM 9:59

REG. OF DEEDS

*Randy Kolehouse*

10869

Register of Deeds Stamp & File Number

For corners in SECTION

Kent (County)	Located in:	Grattan Township	Corner Code #
1. Public Land Survey	T <u>8N</u>	R <u>9W</u>	<u>G-4</u>
	T _____	R _____	_____
	T _____	R _____	_____
	T _____	R _____	_____
2. Property Controlling in Section	S _____	T _____	R _____
	S _____	T _____	R _____
3. Miscellaneous Property in Sec.	S _____	T _____	R _____
	S _____	T _____	R _____
4. Lot No. _____, Recorded Plat _____			
5. Private Claims _____			


I, Randy Kolehouse, in a field survey on March 13 19 98, do hereby certify that under requirements of P.A. 74 Michigan P.A. of 1970, the corner points mentioned in lines 1 and 2 above were in conformance with regulations and rules therefore as required in the current manual of survey instructions of the United States Department of the interior, Bureau of Land Management or by a decree of a Court of Law and/or that the corner points mentioned in lines 3, 4 and 5 above were in conformance with the rules of the Michigan Board of Land Surveyors or by a Decree of a Court of Law; established, re-established, monumented, re-monumented, recovered, found as expressed below:

NOTE: Not more than 4 corners, all in the same town and range, may be recorded on this certificate.

A. Description of original monument and accessories and/or subsequent restoration:

G-4	1837	G.L.O. Notes	Cathcart	Set Post
	N/A	Witness Map	K.C. Surveyor	Stone
	1946-57	Notes	Williams & Works	Iron
	1985	L.C.R.C. #4184	R. Kolehouse	Set K.C. Monument
	1994	L.C.R.C. #8035	Glaza & Associates	K.C. Monument

P.A. 345 1990 KENT COUNTY  
 PEER APPROVED 6/25/98  
 CHAIRMAN *[Signature]*

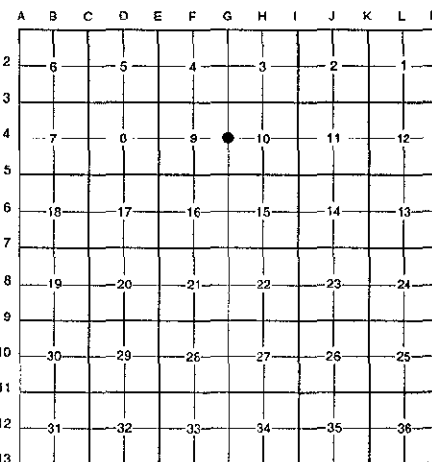

This corner was originally approved by the Kent County Remonumentation Peer Group and monumented by Randy Kolehouse on 3/16/85 and was recorded per L.C.R.C. #4184.

B. Description of corner evidence found and/or method applied in restoring or reestablishing corner:

G-4 Found a Standard Kent County Monument 7' ± West of the C/L of a 2-track running North and South and 33' ± West of a fence line and tree row running North and East per L.C.R.C.'s #4184 and #8035 as set by Randy Kolehouse using the 1946-57 notes of Williams & Works and the K.C. Surveyor's records.

L.C.R.C. #4184

L.C.R.C. #8035

Nail & K.C. Remon. tag in S. side 24" Oak East 40.92'  
 Nail & K.C. Remon. tag in SE side 6" Oak N 40° E 46.55'  
 Nail & K.C. Remon. tag in SE side 6" Oak N 20° E 65.95'


Nail & K.C. remon tag in S side 26" Oak East 40.81' (m. 40.82")  
 Nail & K.C. remon tag in SE side 10" Oak N40°E 46.21' (46.23")  
 Nail & K.C. remon tag in SE side 11" Oak N20°E 65.78' (m. 65.75')

The selected location is accepted by me and is generally accepted by professional surveyors as the best available evidence of the position of the original corner.

C. Description of monument for corner and accessories established to perpetuate locating the position of the corner:

G-4 Standard Kent County Monument

Nail & K.C. remon. tag on S side 26" Oak East 40.82'  
 Nail & K.C. remon. tag on SE side 10" Oak N40°E 46.23"  
 Nail & K.C. remon. tag on SE side 12" Oak N20°E 65.75'  
 C/L of 2-track running N-S, East 7' ±  
 Fence line and tree row running N & E, East 33' ±

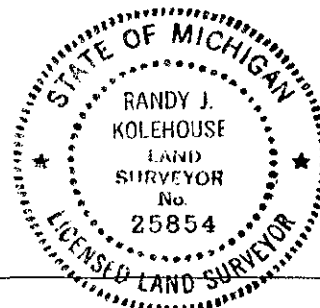

Signed by *Randy J. Kolehouse*  
 EARTH TECH

Date 9-1-98

Surveyor's Michigan License No. 25854