

STABILITY & SECURITY
 \$7.00
 \$2.00
 MAR 08 1999

LAND CORNER RECORDATION CERTIFICATE
Filing Requirement of Act 74, Mich. P.A. 1970
KENT COUNTY REMONUMENTATION


For corners in SECTION
Kent
 (County)

Located in: Grattan Township Corner Code #
 T 8N R 9W G-7
 T _____ R _____
 T _____ R _____
 T _____ R _____
 S _____ T _____ R _____
 S _____ T _____ R _____
 S _____ T _____ R _____
 S _____ T _____ R _____

STATE OF MICHIGAN
 COUNTY OF KENT
 RECEIVED FOR RECORDING
 98 OCT 23 AM 9:59
 REG. OF DEEDS
 10872
 Register of Deeds Stamp & File Number

4. Lot No. _____, Recorded Plat _____
 5. Private Claims _____

I, Randy Kolehouse, in a field survey on February 3 19 98, do hereby certify that under requirements of P.A. 74 Michigan P.A. of 1970, the corner points mentioned in lines 1 and 2 above were in conformance with regulations and rules therefore as required in the current manual of survey instructions of the United States Department of the interior, Bureau of Land Management or by a decree of a Court of Law and/or that the corner points mentioned in lines 3, 4 and 5 above were in conformance with the rules of the Michigan Board of Land Surveyors or by a Decree of a Court of Law; established, re-established, monumented, re-monumented, recovered, found as expressed below:

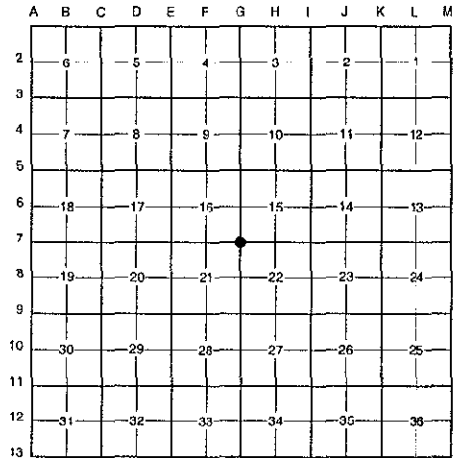

NOTE: Not more than 4 corners, all in the same town and range, may be recorded on this certificate.

A. Description of original monument and accessories and/or subsequent restoration:

G-7	1837	G.L.O. Notes	Cathcart	Set Post
	1947	Witness Map	K.C. Surveyor	N/A
	1976	L.C.R.C. #997	Medema, Van Kooten & Assoc.	1/2" Iron
	1981	L.C.R.C. #2014	Jonker Land Survey	Fnd. 1/2" Iron / Set K.C. Monument
	1986	L.C.R.C. #4431	R. Kolehouse	K.C. Monument
	1994	L.C.R.C. #8038	Glaza & Associates	K.C. Monument

P.A. 345 1990 KENT COUNTY
 PEER APPROVED 6/25/98
 CHAIRMAN [Signature]

This corner was originally approved by the Kent County Remonumentation Peer Group and monumented by Rob Jonker on 6/15/81 and was recorded per L.C.R.C. #2014.

B. Description of corner evidence found and/or method applied in restoring or reestablishing corner:


G-7 Found a Standard Kent County Monument at the C/L intersection of Corrigan Road (gravel) running North and South and 7 Mile Road (gravel) running East and West per L.C.R.C.'s #4431 and #8038 as set by Rob Jonker in place of a 1/2" iron he found which checked L.C.R.C.'s #2014 and #997.

L.C.R.C. #2014	L.C.R.C. #8038
Remon. tag on N side 18" Oak S75°E 80.85'	K.C. remon tag & nail in N side 24" Oak S75°E 80.40' (m. 80.35')
Remon. tag on N side 18" Oak N79°E 101.65'	K.C. remon tag & nail in S side 24" Oak N79°E 101.17' (m. 101.19')
Remon. tag on E side p. pole S28°W 68.79'	K.C. remon tag & nail in E side P. pole S28°W 68.98' (m. 69.00')
C/L top steel corner post N41°W 46.37'	C/L top steel fence post N41°W 46.30' (m. 46.40')

The selected location is accepted by me and is generally accepted by professional surveyors as the best available evidence of the position of the original corner.

C. Description of monument for corner and accessories established to perpetuate locating the position of the corner:

G-7 Standard Kent County Monument
 Nail & K.C. remon. tag on N side 24" Oak S 75° E 80.35'
 Nail & K.C. remon. tag on S side 24" Oak N 79° E 101.19'
 Nail & K.C. remon. tag on E side P. pole S 28° W 69.00'
 C/L top steel fence post N 41° W 46.40'
 On C/L "X" of gravel roads running N-S-E-W

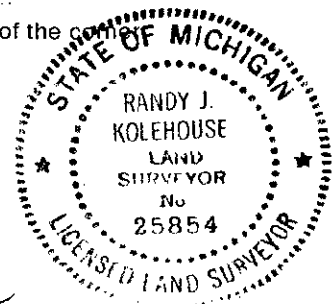

Signed by Randy J. Kolehouse Date 9-1-98
 EARTH TECH

Surveyor's Michigan License No. 25854