

REMONUMENTATION

\$7.00
\$2.00

MAR 28 1999

LAND CORNER RECORDATION CERTIFICATE
Filing Requirement of Act 74, Mich. P.A. 1970
KENT COUNTY REMONUMENTATION

For corners in

SECTION

<u>Kent</u> (County)	Located in:	Grattan Township	Corner Code #
1. Public Land Survey	T <u>8N</u> R <u>9W</u>		<u>G-8</u>
	T _____ R _____		_____
	T _____ R _____		_____
	T _____ R _____		_____
2. Property Controlling in Section	S _____ T _____	R _____	_____
	S _____ T _____	R _____	_____
3. Miscellaneous Property in Sec.	S _____ T _____	R _____	_____
	S _____ T _____	R _____	_____

REG. OF DEEDS

W. J. Colehouse

98 OCT 23 AM 9:59

STATE OF MICHIGAN
 COUNTY OF KENT
 RECEIVED FOR RECORD

10873

Register of Deeds Stamp & File Number


4. Lot No. _____, Recorded Plat _____
 5. Private Claims _____

I, Randy Kolehouse, in a field survey on February 3 19 98, do hereby certify that under requirements of P.A. 74 Michigan P.A. of 1970, the corner points mentioned in lines 1 and 2 above were in conformance with regulations and rules therefore as required in the current manual of survey instructions of the United States Department of the interior, Bureau of Land Management or by a decree of a Court of Law and/or that the corner points mentioned in lines 3, 4 and 5 above were in conformance with the rules of the Michigan Board of Land Surveyors or by a Decree of a Court of Law; established, re-established, monumented, re-monumented, recovered, found as expressed below:

NOTE: Not more than 4 corners, all in the same town and range, may be recorded on this certificate.

A. Description of original monument and accessories and/or subsequent restoration:

G-8	1837	G.L.O. Notes	Cathcart	Set Post
	1947	Witness Map	K.C. Surveyor	Large Stone 4" Down
	1976	L.C.R.C. #996	Medema, Van Kooten & Assoc.	Large Stone with Small Hole
	1980	L.C.R.C. #1451	Williams & Works	Fnd. Stone with Hole in Top / Set K.C. Monument
	1994	L.C.R.C. #8039	Glaza & Associates	K.C. Monument

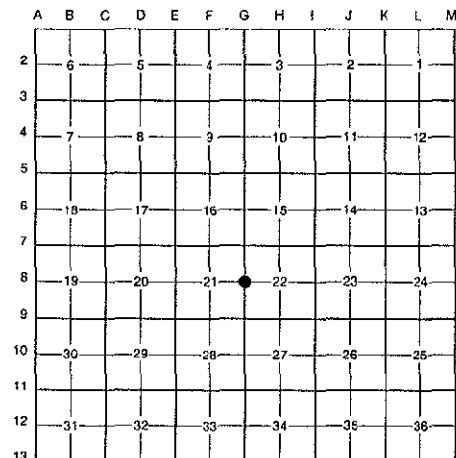

This corner was originally approved by the Kent County Remonumentation Peer Group and monumented by Williams & Works on 10/27/80 and was recorded per L.C.R.C. #1451.

B. Description of corner evidence found and/or method applied in restoring or reestablishing corner:

G-8 Found a Standard Kent County Monument on the C/L of Corrigan Road (gravel) running North and South, 20' South of a fence row running East, on line of a tree row and fence line running West per L.C.R.C.'s #1451 and #8039 as set by Williams & Works in place of a 24" diameter stone they found with a 1/2" hole in the top which checked L.C.R.C. #996 and the K.C. Surveyor's records.

L.C.R.C. #1451

L.C.R.C. #8039

Nail & K.C. Remon. Tag in S. Side 16" Hickory N 65°W 28.00
 Nail & K.C. Remon. Tag in N. Side 18" Hickory N 85°W 17.98
 Nail & K.C. Remon. Tag in NW Side 16" Oak S 35°W 49.73
 Nail & K.C. Remon. Tag in W Side 12" Ash S 25°E 69.04
 in C/L Gravel Road on Fen. Line West

Nail & K.C. remon tag in S side 18" Hickory N65°W 28.34' (m. 28.32')
 Nail & K.C. remon tag in N side 22" Hickory N85°W 17.86' (m. 17.87')
 Nail & K.C. remon tag in NW side 18" Oak S35°W 49.58' (m. 49.56')
 Nail & K.C. remon tag in W side 14" Ash S25°E 68.94' (m. 68.95')
 Nail & K.C. remon tag in NW side 18" Ash N45°E 34.01' (m. 34.00')
 In C/L gravel road on fence line West

The selected location is accepted by me and is generally accepted by professional surveyors as the best available evidence of the position of the original corner.

C. Description of monument for corner and accessories established to perpetuate locating the position of the corner:

G-8 Standard Kent County Monument

Nail & K.C. remon. tag on S side 18" Hickory N 65° W 28.32'
 Nail & K.C. remon. tag on N side 22" Hickory N 85° W 17.87'
 Nail & K.C. remon. tag on NW side 18" Oak S 35° W 49.56'
 Nail & K.C. remon. tag on W side 14" Ash S 25° E 68.95'
 Nail & K.C. remon. tag on NW side 18" Ash N 45° E 34.00'

On C/L of gravel road running N-S
 Fence row running East, North 20'
 On tree row and fence line running W

Signed by *Randy J. Kolehouse*
 EARTH TECH


Date 9-1-98

Surveyor's Michigan License No. 25854

P.A. 345 1990 KENT COUNTY

PEER APPROVED 6/29/99

CHAIRMAN *Hans Huber*

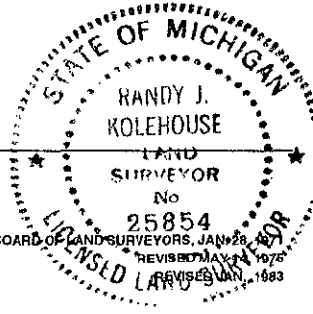

FORM APPROVED BY MICHIGAN STATE BOARD OF LAND SURVEYORS, JAN 28, 1971
 REVISOR MAY 14, 1976
 REVISOR JAN 1, 1993