

STATE OF MICHIGAN
 COUNTY OF KENT
 KENT COUNTY REMONUMENTATION
 08 1993

LAND CORNER RECORDATION CERTIFICATE
Filing Requirement of Act 74, Mich. P.A. 1970
KENT COUNTY REMONUMENTATION


For corners in SECTION
Kent
 (County)

Located in: Grattan Township	Corner Code #
T <u>8N</u> R <u>9W</u>	<u>G-9</u>
T _____ R _____	_____
T _____ R _____	_____
T _____ R _____	_____
S _____ T _____ R _____	_____
S _____ T _____ R _____	_____
S _____ T _____ R _____	_____
S _____ T _____ R _____	_____

STATE OF MICHIGAN
 COUNTY OF KENT
 RECEIVED FOR RECORD
 23 OCT 1998 AM 9:59
 REG. OF DEEDS
Larry J. Kolehuse
10874
 Register of Deeds Stamp & File Number

4. Lot No. _____, Recorded Plat _____
 5. Private Claims _____

I, Randy Kolehuse, in a field survey on February 2, 1998, do hereby certify that under requirements of P.A. 74 Michigan P.A. of 1970, the corner points mentioned in lines 1 and 2 above were in conformance with regulations and rules therefore as required in the current manual of survey instructions of the United States Department of the Interior, Bureau of Land Management or by a decree of a Court of Law and/or that the corner points mentioned in lines 3, 4 and 5 above were in conformance with the rules of the Michigan Board of Land Surveyors or by a Decree of a Court of Law; established, re-established, monumented, re-monumented, recovered, found as expressed below:

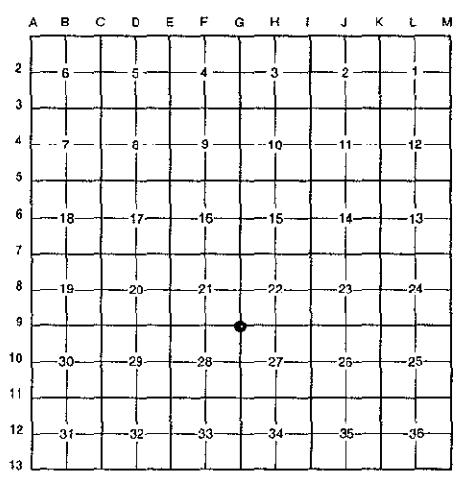

NOTE: Not more than 4 corners, all in the same town and range, may be recorded on this certificate.

A. Description of original monument and accessories and/or subsequent restoration:

G-9	1837	G.L.O. Notes	Cathcart	Set Post
	1947	Witness Map	K.C. Surveyor	Leaded Stone
	1978	L.C.R.C. #1185	Williams & Works	Leaded Stone
	1981	L.C.R.C. #2015	Jonker Land Survey	Fnd. Leaded Stone / Set K.C. Monument
	1994	L.C.R.C. #8040	Glaza & Associates	K.C. Monument

This corner was originally approved by the Kent County Remonumentation Peer Group and monumented by Rob Jonker on 6/15/81 and was recorded per L.C.R.C. #2015.

B. Description of corner evidence found and/or method applied in restoring or reestablishing corner:

G-9 Found a Standard Kent County Monument (.5' below grade) 6' North of the C/L intersection of 6 Mile Road (gravel) running East and West and the C/L of Corrigan Road (gravel) running North per L.C.R.C.'s #2015 and #8040 as set by Rob Jonker in place of a leaded stone he found which checked L.C.R.C. #1185 and the K.C. Surveyor's records.


L.C.R.C. #2015	L.C.R.C. #8040
Remon. tag on E. side Oak N23°W 50.00'	K.C. remon tag & nail in E side 24" Twin Oak N23°W 50.08' (m. 50.05')
Remon. tag on N. side 12" Hickory S65°W 49.05'	K.C. remon tag & nail in N side 12" Hickory S65°W 49.04' (m. 49.03')
Leaded stone S. 32.3'	K.C. remon tag & nail in E side 9" Tree S15°E 43.64' (m. 43.71')
C/L "X" gravel 6'S.	K.C. remon tag & nail in N side 10" Twin Tree S65°E 71.10' (m. 71.09')

The selected location is accepted by me and is generally accepted by professional surveyors as the best available evidence of the position of the original corner.

C. Description of monument for corner and accessories established to perpetuate locating the position of the corner:

G-9 Standard Kent County Monument
 Nail & K.C. remon. tag on E side 24" Twin Oak N 23° W 50.05'
 Nail & K.C. remon. tag on N side 12" Hickory S 65° W 49.03'
 Nail & K.C. remon. tag on E side 10" Elm S 15° E 43.71'
 Nail & K.C. remon. tag on N side 10" Twin Hickory S 65° E 71.09'
 Leaded stone South 32.38'
 C/L "X" of gravel roads running N-E-W, South 6.0'

P.A. 345 1990 KENT COUNTY
 PEER APPROVED 6/25/98
 CHAIRMAN *Randy Kolehuse*

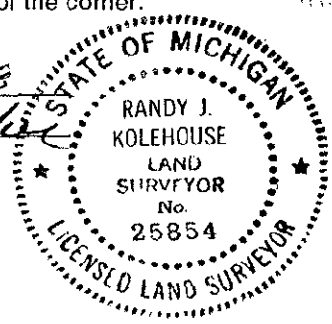

Signed by *Randy J. Kolehuse*
 EARTH TECH

Date 9-1-98

Surveyor's Michigan License No. 25854