

STATE OF MICHIGAN
 COUNTY OF KENT
 08 1993

LAND CORNER RECORDATION CERTIFICATE
Filing Requirement of Act 74, Mich. P.A. 1970
KENT COUNTY REMONUMENTATION

For corners in SECTION

<u>Kent</u> (County)	Located in: Grattan Township	Corner Code #
1. Public Land Survey	T <u>8N</u> R <u>9W</u>	<u>G-10</u>
	T _____ R _____	_____
	T _____ R _____	_____
	T _____ R _____	_____
2. Property Controlling in Section	S _____ T _____ R _____	_____
	S _____ T _____ R _____	_____
3. Miscellaneous Property in Sec.	S _____ T _____ R _____	_____
	S _____ T _____ R _____	_____
4. Lot No. _____, Recorded Plat _____		
5. Private Claims _____		

STATE OF MICHIGAN
 COUNTY OF KENT
 RECEIVED FOR RECORD
 98 OCT 23 AM 9:59
 REG. OF DEEDS
Tim Stand

10875

Register of Deeds Stamp & File Number


I, Randy Kolehouse, in a field survey on March 13 1998, do hereby certify that under requirements of P.A. 74 Michigan P.A. of 1970, the corner points mentioned in lines 1 and 2 above were in conformance with regulations and rules therefore as required in the current manual of survey instructions of the United States Department of the interior, Bureau of Land Management or by a decree of a Court of Law and/or that the corner points mentioned in lines 3, 4 and 5 above were in conformance with the rules of the Michigan Board of Land Surveyors or by a Decree of a Court of Law; established, re-established, monumented, re-monumented, recovered, found as expressed below:

NOTE: Not more than 4 corners, all in the same town and range, may be recorded on this certificate.

A. Description of original monument and accessories and/or subsequent restoration:

G-10	1837	G.L.O. Notes	Cathcart	Set Post
	1880	Notes	Williams & Works	Set Stone
	1944	Notes	Williams & Works	Large Stone
	1967	Notes	Williams & Works	Stone
	1944	Witness Map	K.C. Surveyor	Leaded Stone
	1984	L.C.R.C. #3754	R. Kolehouse	Fnd. Stone / Set K.C. Monument
	1994	L.C.R.C. #8041	Glaza & Associates	K.C. Monument

P.A. 345 1990 KENT COUNTY
 PEER APPROVED 6/25/98
 CHAIRMAN *Frank Fisher*

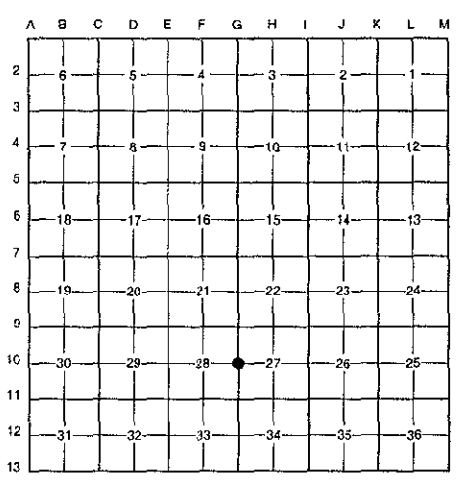

This corner was originally approved by the Kent County Remonumentation Peer Group and monumented by Randy Kolehouse in February 1984 and was recorded per L.C.R.C. #3754.

B. Description of corner evidence found and/or method applied in restoring or reestablishing corner:

G-10 Found a Standard Kent County Monument on line of a tree row running South and a fence line running East and South per L.C.R.C.'s #3754 and #8041 as set by Randy Kolehouse in place of a stone he found on the South side of a corner fence post which check the notes of Williams & Works and the K.C. Surveyor's records.

L.C.R.C. #3754	L.C.R.C. #8041
Nail & K.C. Remon. tag in W. side 14" Hickory N 15° E 27.23'	Nail & K.C. remon tag in W side 16" Hickory N15°E 27.23' (m. 27.24')
Nail & K.C. Remon. tag in S. side 24" Oak N 70° E 14.80'	Nail & K.C. remon tag in S side 24" Oak N70°E 14.75' (m. 14.76')
Nail & K.C. Remon. tag in S. side 24" Oak N 45° W 9.24'	Nail & K.C. remon tag I S side 24" Oak N45°W 9.20' (m. 9.23')
Nail & K.C. Remon. tag in NW side 12" Hickory S 20° W 20.37'	Nail & K.C. remon tag in NW side 14" Hickory S20°W 20.37'

The selected location is accepted by me and is generally accepted by professional surveyors as the best available evidence of the position of the original corner.

C. Description of monument for corner and accessories established to perpetuate locating the position of the corner:

- G-10 Standard Kent County Monument
- Nail & K.C. remon. tag on W side 16" Hickory N 15° E 27.24'
 - Nail & K.C. remon. tag on S side 24" Oak N 70° E 14.76'
 - Nail & K.C. remon. tag on S side 24" Oak N 45° W 9.23'
 - Nail & K.C. remon. tag on NW side 14" Hickory S 20° W 20.37'
 - On tree row running S
 - On fence line running E & S

Signed by *Randy J Kolehouse* Date 9-1-98
 EARTH TECH
 Surveyor's Michigan License No. 25854

