

\$7.00
\$2.00

DEC 08 1999

LAND CORNER RECORDATION CERTIFICATE
Filing Requirement of Act 74, Mich. P.A. 1970
KENT COUNTY REMONUMENTATION

SECTION

For corners in


Kent (County)	Located in:	Grattan Township	Corner Code #
1. Public Land Survey	T <u>8N</u>	R <u>9W</u>	<u>G-13</u>
	T _____	R _____	_____
	T _____	R _____	_____
	T _____	R _____	_____
2. Property Controlling in Section	S _____	T _____	R _____
	S _____	T _____	R _____
3. Miscellaneous Property in Sec.	S _____	T _____	R _____
	S _____	T _____	R _____

STATE OF MICHIGAN
COUNTY OF KENT
RECEIVED FOR RECORD
38 DEC 14 AM 8:00
REG. OF DEEDS
Lucy Spauld

10976

Register of Deeds Stamp & File Number

4. Lot No. _____, Recorded Plat _____
5. Private Claims _____

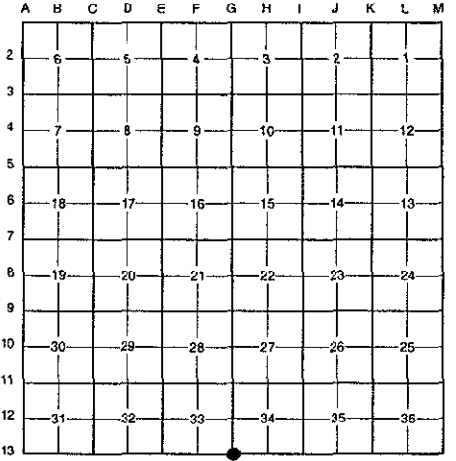

I, Randy Kolehouse, in a field survey on December 31 19 97, do hereby certify that under requirements of P.A. 74 Michigan P.A. of 1970, the corner points mentioned in lines 1 and 2 above were in conformance with regulations and rules therefore as required in the current manual of survey instructions of the United States Department of the interior, Bureau of Land Management or by a decree of a Court of Law and/or that the corner points mentioned in lines 3, 4 and 5 above were in conformance with the rules of the Michigan Board of Land Surveyors or by a Decree of a Court of Law; established, re-established, monumented, re-monumented, recovered, found as expressed below:

NOTE: Not more than 4 corners, all in the same town and range, may be recorded on this certificate.

A. Description of original monument and accessories and/or subsequent restoration:

G-13	1837	G.L.O. Notes	N. Brookfield	Set Post
	1941-1964	Witness Map	K.C. Surveyor	1-1/2" Pipe
	1976	L.C.R.C. #995	Medema, Van Kooten & Assoc.	1-1/2" Iron
	1980	L.C.R.C. #1355	Williams & Works	1" Iron (G-1, T7N, R9W)
	1981	L.C.R.C. #1783	Williams & Works	Fnd. 1-1/2" Iron Pipe / Set K.C. Monument
	1994	L.C.R.C. #8044	Glaza & Associates	K.C. Monument

P.A. 345 1990 KENT COUNTY
PEER APPROVED 9/24/98
CHAIRMAN Harry Tuttle

Note: This corner is common with G-1, T7N, R9W.

This corner was originally approved by the Kent County Remonumentation Peer Group and monumented by Williams & Works on 1/26/81 and was recorded per L.C.R.C. #1783.

B. Description of corner evidence found and/or method applied in restoring or reestablishing corner:

G-13 Found a Standard Kent County Monument on the C/L of Alden Nash (bit.) extended North and running South and on the C/L of 4 Mile Road (bit.) extended West and running East per L.C.R.C.'s #1783 and #8044 as set by Williams & Works in place of a 1-1/2" iron pipe they found which checked L.C.R.C.'s #1355, #995 and the K.C. Surveyor's records.

L.C.R.C. #1783

L.C.R.C. #8044


K.C. Remon. Tag & Nail in NW Side T&P Pole N 60° E 63.61'
K.C. Remon. Tag & Nail in S. Side 10" Spruce N 55° W 48.22'
K.C. Remon. Tag & Nail in N. Side 10" Spruce S 85° W 44.02'
K.C. Remon. Tag & Nail in E. Side P. Pole S 20° W 118.34'
SW Cor. Hse. Fnd. N 05° W 86.16'

K.C. remon tag & nail in SE side T&P Pole N 60° E 63.75' (63.72')
K.C. remon tag & nail in S side 18" Spruce N 55° W 48.01' (m. 48.02')
K.C. remon tag & nail in N side 18" Spruce S 85° W 43.84' (m. 43.82')
K.C. remon tag & nail in E side P. Pole S 20° W 118.40' (m. 118.42')
SW corner house foundation N 05° W 86.10' (m. 86.12')

The selected location is accepted by me and is generally accepted by professional surveyors as the best available evidence of the position of the original corner.

C. Description of monument for corner and accessories established to perpetuate locating the position of the corner:

G-13 Standard Kent County Monument
Nail & K.C. remon. tag on SE side P. pole N 60° E 63.72'
Nail & K.C. remon. tag on S side 14" Spruce N 55° W 48.02'
Nail & K.C. remon. tag on N side 14" Spruce S 85° W 43.82'
Nail & K.C. remon. tag on E side P. pole S 20° W 118.42'
Nail & K.C. remon. tag on N side P. pole S 75° E 122.43'
Fnd. SW cor. hse. fndn. N 15° W 86.12'

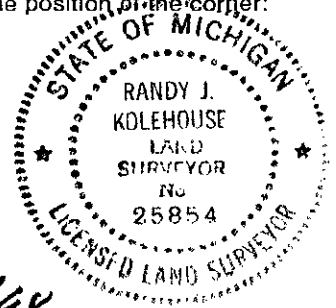

Signed by Randy J. Kolehouse
EARTH TECH

Date 11/18/98

Surveyor's Michigan License No. 25854