

SURVEY & REMONUMENTATION

MAR 08 1999

\$7.00
\$2.00

LAND CORNER RECORDATION CERTIFICATE
Filing Requirement of Act 74, Mich. P.A. 1970
KENT COUNTY REMONUMENTATION

SECTION

STATE OF MICHIGAN
COUNTY OF KENT
RECEIVED FOR RECORD
38 DEC 23 AM 8:58
REG. OF DEEDS
Lucy Bond

11073

Register of Deeds Stamp & File Number

For corners in Kent (County)

Located in: Grattan Township Corner Code #

1. Public Land Survey	T <u>8N</u> R <u>9W</u>	<u>H-2</u>
	T _____ R _____	_____
	T _____ R _____	_____
	T _____ R _____	_____
2. Property Controlling in Section	S _____ T _____ R _____	_____
	S _____ T _____ R _____	_____
3. Miscellaneous Property in Sec.	S _____ T _____ R _____	_____
	S _____ T _____ R _____	_____

4. Lot No. _____, Recorded Plat _____

5. Private Claims _____

A	B	C	D	E	F	G	H	I	J	K	L	M
2	6	5	4				●	2				
3												
4	7	8	9	10	11	12						
5												
6	18	17	16	15	14	13						
7												
8	19	20	21	22	23	24						
9												
10	30	29	28	27	26	25						
11												
12	31	32	33	34	35	36						
13												

I, Randy Kolehouse, in a field survey on December 4 19 98, do hereby certify that under requirements of P.A. 74 Michigan P.A. of 1970, the corner points mentioned in lines 1 and 2 above were in conformance with regulations and rules therefore as required in the current manual of survey instructions of the United States Department of the interior, Bureau of Land Management or by a decree of a Court of Law and/or that the corner points mentioned in lines 3, 4 and 5 above were in conformance with the rules of the Michigan Board of Land Surveyors or by a Decree of a Court of Law; established, re-established, monumented, re-monumented, recovered, found as expressed below:

NOTE: Not more than 4 corners, all in the same town and range, may be recorded on this certificate.

A. Description of original monument and accessories and/or subsequent restoration:
H-2 This corner was not originally set by the G.L.O.


No information on record for this corner.
N/A 1971 Witness Map Survey Records K.C. Monument Williams & Works 1" Iron Set Iron at Int. 1/4 Lines

P.A. 345 1990 KENT COUNTY
PEER APPROVED 8/20/98
CHAIRMAN [Signature]

B. Description of corner evidence found and/or method applied in restoring or reestablishing corner:
H-2 In 1971 Williams & Works surveyed all of Section 3 and found an existing iron at the Center of Section to be 7.15' South of the intersection of 1/4 lines and reset at the intersection of 1/4 lines. Did not find this iron but did find a concrete monument 8.7' West and 0.8' South of the intersection of 1/4 lines (no record of corner). Set a monument at the intersection of 1/4 lines. Monument is on the approximate C/L intersection extended of Heffron Road (bit.) running West and McArthur Road (bit.) running North.

The selected location is accepted by me and is generally accepted by professional surveyors as the best available evidence of the position of the original corner.*

C. Description of monument for corner and accessories established to perpetuate locating the position of the corner:
H-2 Set a Standard Kent County Monument
Nail & K.C. remon. tag on N side 24" Oak S 75° W 20.16'
Nail & K.C. remon. tag on S side 8" Maple N 57° W 12.92'
Nail & K.C. remon. tag on S side 4" Maple N 72° E 7.41'
Nail & K.C. remon. tag on NE side 8" Maple S 65° E 18.52'
Conc. Mon. 8.7' ± West and 0.8' ± South

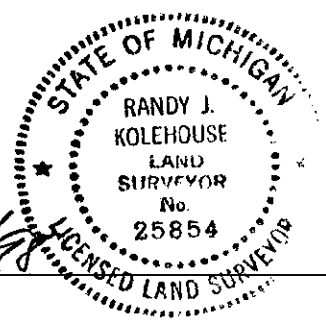

Signed by [Signature] Date 12/14/98
EARTH TECH
Surveyor's Michigan License No. 25854