

REMONUMENTATION

7.00  
2.00  
MAR 08 1999

LAND CORNER RECORDATION CERTIFICATE  
Filing Requirement of Act 74, Mich. P.A. 1970  
KENT COUNTY REMONUMENTATION

For corners in SECTION

Kent (County)	Located in:	Grattan Township	Corner Code #
1. Public Land Survey	T <u>8N</u>	R <u>9W</u>	<u>H-3</u>
	T _____	R _____	_____
	T _____	R _____	_____
	T _____	R _____	_____
2. Property Controlling in Section	S _____	T _____	R _____
	S _____	T _____	R _____
3. Miscellaneous Property in Sec.	S _____	T _____	R _____
	S _____	T _____	R _____


STATE OF MICHIGAN  
COUNTY OF KENT  
RECEIVED FOR RECORDS  
98 OCT 23 AM 9:59  
REG. OF DEEDS  
*W. J. Stand*

10878

Register of Deeds Stamp & File Number

4. Lot No. \_\_\_\_\_, Recorded Plat \_\_\_\_\_  
5. Private Claims \_\_\_\_\_

I, Randy Kolehouse, in a field survey on March 19 19 98, do hereby certify that under requirements of P.A. 74 Michigan P.A. of 1970, the corner points mentioned in lines 1 and 2 above were in conformance with regulations and rules therefore as required in the current manual of survey instructions of the United States Department of the interior, Bureau of Land Management or by a decree of a Court of Law and/or that the corner points mentioned in lines 3, 4 and 5 above were in conformance with the rules of the Michigan Board of Land Surveyors or by a Decree of a Court of Law; established, re-established, monumented, re-monumented, recovered, found as expressed below:

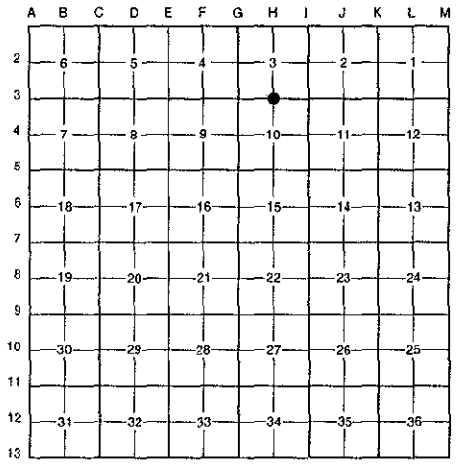

NOTE: Not more than 4 corners, all in the same town and range, may be recorded on this certificate.

A. Description of original monument and accessories and/or subsequent restoration:

H-3	1837	G.L.O. Notes	Cathcart	Set Post
	1979	L.C.R.C. #1249	C. Fricke	Concrete Monument
	1981	L.C.R.C. #2004	Jonker Land Survey	Fnd. Concrete Monument / Set K.C. Monument
	1991	L.C.R.C. #5867	William Byl	K.C. Monument

P.A. 345 1990 KENT COUNTY  
PEER APPROVED 6/25/98  
CHAIRMAN *[Signature]*

This corner was originally approved by the Kent County Remonumentation Peer Group and monumented by Rob Jonker on 8/12/81 and was recorded per L.C.R.C. #2004.


B. Description of corner evidence found and/or method applied in restoring or reestablishing corner:

H-3	L.C.R.C. #2004	L.C.R.C. #5867
	Remon. tag on SE side 14" Oak S15°E 8.31'	Nail & KC Remon. tag SE side 18" Oak S15°E 8.30' (m. 8.33')
	Remon. tag on E side 12" Oak N02°W 8.89'	Nail & KC Remon. tag E side 18" Oak N02°W 8.82' (m. 8.97')
	Remon. tag on S side p.pole N75°E 33.80'	Nail & KC Remon. tag S. side P. Pole N75°E 33.80' (m. 34.67')

The selected location is accepted by me and is generally accepted by professional surveyors as the best available evidence of the position of the original corner.

C. Description of monument for corner and accessories established to perpetuate locating the position of the corner:  
H-3 Standard Kent County Monument

- Nail & K.C. remon. tag on SE side 18" stump S 15° E 8.33'
- Nail & K.C. remon. tag on E side 18" Oak N 02° W 8.97'
- Nail & K.C. remon. tag on S side P. pole N 75° E 34.67'
- Nail & K.C. remon. tag on NE side 8" Oak N 42° W 20.29'
- East edge of lake, West 200'

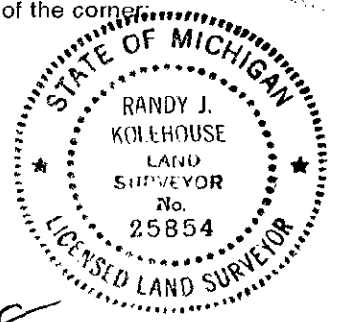

Signed by *Randy J. Kolehouse* Date 9-1-98  
EARTH TECH

Surveyor's Michigan License No. 25854