

MAR 08 1999

\$7.00
\$2.00

SECTION

LAND CORNER RECORDATION CERTIFICATE
Filing Requirement of Act 74, Mich. P.A. 1970
KENT COUNTY REMONUMENTATION

STATE OF MICHIGAN
COUNTY OF KENT
RECEIVED FOR RECORD
38 DEC 14 AM 8:00
REG. OF DEEDS
Luis J. Sand

For corners in


Kent (County)	Located in:	Grattan Township	Corner Code #
1. Public Land Survey	T <u>8N</u>	R <u>9W</u>	<u>H-4</u>
	T _____	R _____	_____
	T _____	R _____	_____
	T _____	R _____	_____
2. Property Controlling in Section	S _____	T _____	R _____
	S _____	T _____	R _____
3. Miscellaneous Property in Sec.	S _____	T _____	R _____
	S _____	T _____	R _____

11045

Register of Deeds Stamp & File Number

- 4. Lot No. _____, Recorded Plat _____
- 5. Private Claims _____

I, Randy Kolehouse, in a field survey on August 7 19 98, do hereby certify that under requirements of P.A. 74 Michigan P.A. of 1970, the corner points mentioned in lines 1 and 2 above were in conformance with regulations and rules therefore as required in the current manual of survey instructions of the United States Department of the interior, Bureau of Land Management or by a decree of a Court of Law and/or that the corner points mentioned in lines 3, 4 and 5 above were in conformance with the rules of the Michigan Board of Land Surveyors or by a Decree of a Court of Law; established, re-established, monumented, re-monumented, recovered, found as expressed below:

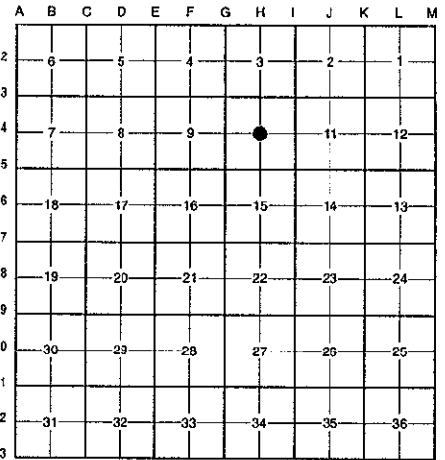

NOTE: Not more than 4 corners, all in the same town and range, may be recorded on this certificate.

A. Description of original monument and accessories and/or subsequent restoration:

H-4 This corner was not originally set by the G.L.O.
1962 Survey Records Williams & Works Iron in Stone Pile

P.A. 345 1990 KENT COUNTY
PEER APPROVED 8/20/98
CHAIRMAN [Signature]


B. Description of corner evidence found and/or method applied in restoring or reestablishing corner:

H-4 Found an iron rod with cap "REDA" in a pile of stones per the 1962 survey records of Williams & Works. Iron rod is 16.2' East and 1.3' North of the intersection of 1/4 lines. Accepted iron rod as Center of Section.

The selected location is accepted by me and is generally accepted by professional surveyors as the best available evidence of the position of the original corner.

C. Description of monument for corner and accessories established to perpetuate locating the position of the corner:

H-4 Replaced Iron Rod with a Standard Kent County Monument
Nail & K.C. remon. tag on NE side 10" Maple S 67° E 15.27'
Nail & K.C. remon. tag on SW side 14" Maple S 20° E 13.65'
Nail & K.C. remon. tag on NW'y side 20" Stump S 44° W 21.30'
Nail & K.C. remon. tag on NE side 12" Maple N 30° W 14.24'

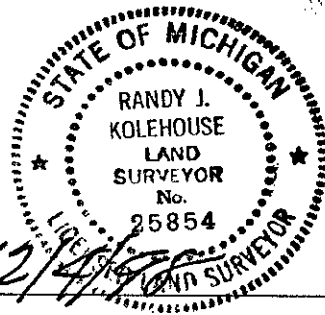

Signed by [Signature] Date 12/4/98
EARTH TECH

Surveyor's Michigan License No. 25854