

SECTION
 16 08 1393

LAND CORNER RECORDATION CERTIFICATE
Filing Requirement of Act 74, Mich. P.A. 1970
KENT COUNTY REMONUMENTATION

For corners in


Kent (County)	Located in:	Grattan Township	Corner Code #
1. Public Land Survey	T <u>8N</u>	R <u>9W</u>	<u>H-5</u>
	T _____	R _____	_____
	T _____	R _____	_____
	T _____	R _____	_____
2. Property Controlling in Section	S _____	T _____	R _____
	S _____	T _____	R _____
3. Miscellaneous Property in Sec.	S _____	T _____	R _____
	S _____	T _____	R _____

4. Lot No. _____, Recorded Plat _____
 5. Private Claims _____

STATE OF MICHIGAN
 COUNTY OF KENT
 RECEIVED FOR RECORD
 38 OCT 23 AM 9:59
 REG. OF DEEDS
Lucy Bond

10879
 Register of Deeds Stamp & File Number

I, Randy Kolehouse, in a field survey on March 19 19 98, do hereby certify that under requirements of P.A. 74 Michigan P.A. of 1970, the corner points mentioned in lines 1 and 2 above were in conformance with regulations and rules therefore as required in the current manual of survey instructions of the United States Department of the interior, Bureau of Land Management or by a decree of a Court of Law and/or that the corner points mentioned in lines 3, 4 and 5 above were in conformance with the rules of the Michigan Board of Land Surveyors or by a Decree of a Court of Law; established, re-established, monumented, re-monumented, recovered, found as expressed below:

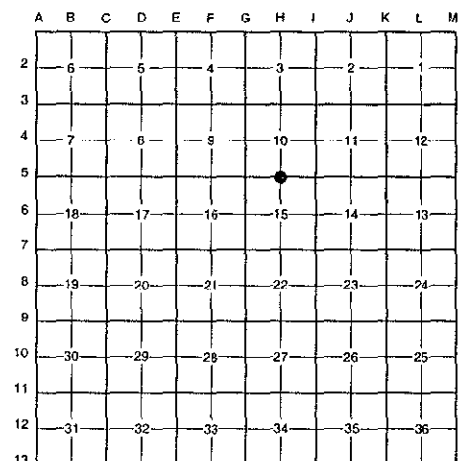

NOTE: Not more than 4 corners, all in the same town and range, may be recorded on this certificate.

A. Description of original monument and accessories and/or subsequent restoration:

H-5	1837	G.L.O. Notes	Cathcart	Set Post
	N/A	Witness Map	K.C. Surveyor	Iron
	1973	L.C.R.C. #543	Williams & Works	"T" Iron
	1982	L.C.R.C. #2683	Jonker Land Survey	Fnd. "T" Iron / Set K.C. Monument
	1991	L.C.R.C. #5868	William Byl	K.C. Monument

P.A. 345 1990 KENT COUNTY
 PEER APPROVED 6/29/98
 CHAIRMAN Randy Kolehouse

This corner was originally approved by the Kent County Remonumentation Peer Group and monumented by Rob Jonker on 6/17/81 and was recorded per L.C.R.C. #2683.

B. Description of corner evidence found and/or method applied in restoring or reestablishing corner:

H-5 Found a Standard Kent County Monument on line of a tree row running North and South and 25' ± East of East edge of apple orchard running North and South per L.C.R.C.'s #2683 and #5868 as set by Rob Jonker in place of a "T" iron he found at grade beside a 2" pipe 2' above ground which checked L.C.R.C. #543 and the K.C. Surveyor's records.

L.C.R.C. #2683

L.C.R.C. #5868

Remon. tag on E side 16" W. Cherry S13°E 4.97'
 Remon. tag on S side 6" Hickory N90°E 12.63'
 Remon. tag on NE side 8" Oak S41°E 40.93'


KC Remon. tag & nail E. side 24" W. Cherry S13°E 5.04' (m. 5.06')
 KC Remon. tag & nail S. side 8" Hickory N90°E 12.74'
 KC Remon. tag & nail NE side 12" Oak S41°E 40.79' (m. 40.75')

The selected location is accepted by me and is generally accepted by professional surveyors as the best available evidence of the position of the original corner.

C. Description of monument for corner and accessories established to perpetuate locating the position of the corner:

H-5 Standard Kent County Monument

Nail & K.C. remon. tag on E side 24" W. Cherry S 13° E 5.06'
 Nail & K.C. remon. tag on S side 8" Hickory N 90° E 12.74'
 Nail & K.C. remon. tag on NE side 12" Oak S 41° E 40.75'
 On tree row running N-S
 East edge of apple orchard running N-S, West 25' ±

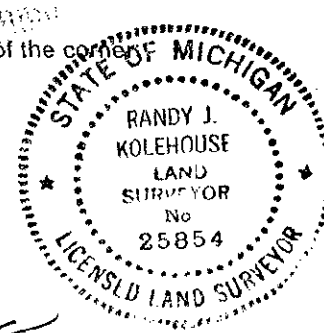

Signed by Randy J. Kolehouse
 EARTH TECH

Date 9-1-98

Surveyor's Michigan License No. 25854