

KENT COUNTY A  
REMONUMENTATION

RECEIVED  
JAN 9 8 1990

SECTION

**LAND CORNER RECORDATION CERTIFICATE**  
Filing Requirement of Act 74, Mich. P.A. 1970  
KENT COUNTY REMONUMENTATION

For corners in

Kent (County)	Located in: Grattan Township	Corner Code #
1. Public Land Survey	T <u>8N</u> R <u>9W</u>	<u>H-7</u>
	T _____ R _____	_____
	T _____ R _____	_____
	T _____ R _____	_____
2. Property Controlling in Section	S _____ T _____ R _____	_____
	S _____ T _____ R _____	_____
3. Miscellaneous Property in Sec.	S _____ T _____ R _____	_____
	S _____ T _____ R _____	_____
4. Lot No. _____, Recorded Plat _____		
5. Private Claims _____		

STATE OF MICHIGAN  
COUNTY OF KENT  
RECEIVED FOR RECORD  
38 OCT 23 AM 9:59  
REG. OF DEEDS  
*Lucy Bond*

10880


Register of Deeds Stamp & File Number

I, Randy Kolehouse, in a field survey on February 27 19 98, do hereby certify that under requirements of P.A. 74 Michigan P.A. of 1970, the corner points mentioned in lines 1 and 2 above were in conformance with regulations and rules therefore as required in the current manual of survey instructions of the United States Department of the Interior, Bureau of Land Management or by a decree of a Court of Law and/or that the corner points mentioned in lines 3, 4 and 5 above were in conformance with the rules of the Michigan Board of Land Surveyors or by a Decree of a Court of Law; established, re-established, monumented, re-monumented, recovered, found as expressed below:

NOTE: Not more than 4 corners, all in the same town and range, may be recorded on this certificate.

A. Description of original monument and accessories and/or subsequent restoration:

H-7	1837	G.L.O. Notes	Cathcart	Set Post
	1947	Witness Map	K.C. Surveyor	Leaded Stone
	1975	L.C.R.C. #3270	C. Hay	"T" Iron
	1988	L.C.R.C. #4915	C. Marschall	Fnd. Leaded Stone with "T" Iron / Set K.C. Monument
	1991	L.C.R.C. #5869	William Byl	K.C. Monument

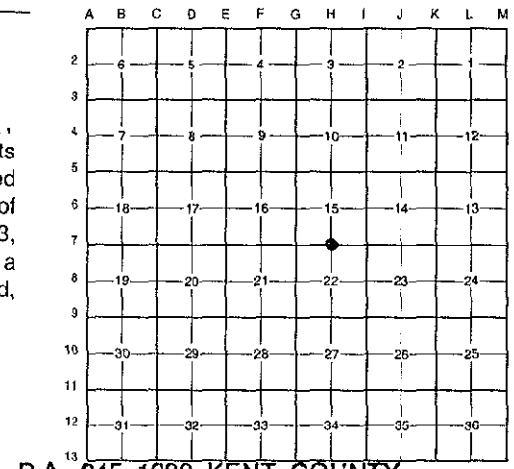

P.A. 345 1990 KENT COUNTY  
PEER APPROVED 6/25/98  
CHAIRMAN Harry Huber

This corner was originally approved by the Kent County Remonumentation Peer Group and monumented by C. Marschall on 11/3/88 and was recorded per L.C.R.C. #4915.

B. Description of corner evidence found and/or method applied in restoring or reestablishing corner:

H-7 Found a Standard Kent County Monument 2' South of the C/L of 7 Mile Road (gravel) running East and West and 8' West of the C/L of Scalley Road (gravel) running South per L.C.R.C.'s #4915 and #5869 as set by C. Marschall in place of a "T" iron and leaded stone he found which checked L.C.R.C. #3270 and the K.C. Surveyor's records.

L.C.R.C. #4915

L.C.R.C. #5869

Nail & KC remon tag in NW side 6" hickory N30°E 30.96'  
Nail & KC remon tag | SW side 10" ash N55°W 45.08'  
Nail & KC remon tag in NW side 10"-12" twin apple S32°W 116.03'  
Nail & KC remon tag in E side 8" apple S23°E 93.70'  
NE corner house (concrete block foundation) S73°W 121.38'

Nail & KC Remon. tag NW side 6" Hickory N30°E 31.03' (m. 31.02')  
Nail & KC Remon. tag SW side 10" Ash N55°W 45.08' (m. 45.10')  
Nail & KC Remon. tag NW side 10"-12" Tw. Apple S32°W 116.07' (m. 116.12")  
Nail & KC Remon. tag E. side 8" Apple S23°E 93.87' (m. 93.72")  
NE corner house (conc. blk. fdn.) S73°W 121.69' (m. 121.74')  
C/L Grav. Rd. South East 8'  
C/L Grav. Rd. E-W North 4'

The selected location is accepted by me and is generally accepted by professional surveyors as the best available evidence of the position of the original corner.

C. Description of monument for corner and accessories established to perpetuate locating the position of the corner:

H-7 Standard Kent County Monument

Nail & K.C. remon. tag on NW side 8" Hickory N 30° E 31.02'  
Nail & K.C. remon. tag on SW side 10" Ash N 55° W 45.10'  
Nail & K.C. remon. tag on NW side 10"-12" Twin Apple S 32° W 116.12'  
Nail & K.C. remon. tag on E side 8" Apple S 23° E 93.72'  
NE corner house (conc. blk. fndn.) S 73° W 121.74'

C/L gravel road running E-W, North 2'  
C/L gravel road running S, East 8'

Signed by Randy J Kolehouse  
EARTH TECH

Date 9-1-98

Surveyor's Michigan License No. 25854

