

SURVEY & REMONUMENTATION

\$7.00
\$2.00

MAR 08 1999

LAND CORNER RECORDATION CERTIFICATE
Filing Requirement of Act 74, Mich. P.A. 1970
KENT COUNTY REMONUMENTATION

For corners in SECTION


Kent (County)	Located in:	Grattan Township	Corner Code #
1. Public Land Survey	T <u>8N</u>	R <u>9W</u>	<u>H-8</u>
	T _____	R _____	_____
	T _____	R _____	_____
	T _____	R _____	_____
2. Property Controlling in Section	S _____	T _____	R _____
	S _____	T _____	R _____
3. Miscellaneous Property in Sec.	S _____	T _____	R _____
	S _____	T _____	R _____

STATE OF MICHIGAN
COUNTY OF KENT
RECEIVED FOR RECORD
98 DEC 14 AM 8:00
REG. OF DEEDS
Eric Sand

10978
Register of Deeds Stamp & File Number

4. Lot No. _____, Recorded Plat _____
5. Private Claims _____

I, Randy Kolehouse, in a field survey on February 27 19 98, do hereby certify that under requirements of P.A. 74 Michigan P.A. of 1970, the corner points mentioned in lines 1 and 2 above were in conformance with regulations and rules therefore as required in the current manual of survey instructions of the United States Department of the interior, Bureau of Land Management or by a decree of a Court of Law and/or that the corner points mentioned in lines 3, 4 and 5 above were in conformance with the rules of the Michigan Board of Land Surveyors or by a Decree of a Court of Law; established, re-established, monumented, re-monumented, recovered, found as expressed below:

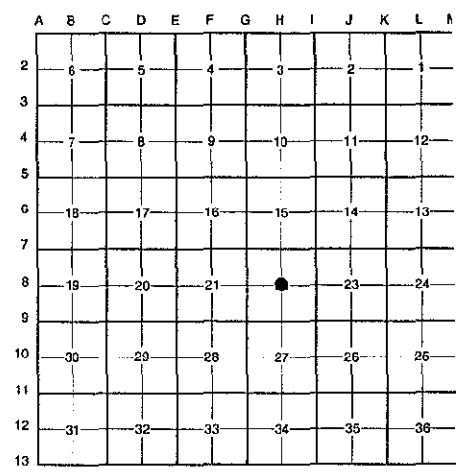

NOTE: Not more than 4 corners, all in the same town and range, may be recorded on this certificate.

A. Description of original monument and accessories and/or subsequent restoration:

H-8	Description	Surveyor	Material
	This corner was not originally set by the G.L.O.		
1880	Survey Notes	C.E. Cole	N/A
N/A	Witness Map	K.C. Surveyor	Iron
1987	L.C.R.C. #4491	Glaza & Associates	3/4" Iron Pipe
1987	Cert. Survey L. 178 P. 5	Glaza & Associates	Iron
1988	Cert. Survey L. 197 P. 11	Glaza & Associates	Iron

P.A. 345 1990 KENT COUNTY
PEER APPROVED 8/20/98
CHAIRMAN Randy Kolehouse

B. Description of corner evidence found and/or method applied in restoring or reestablishing corner:

H-8 Found a 3/4" iron pipe 7' East of the C/L of Scalley Road (gravel) running North and South, on the South edge of drive opening to apple orchard, per L.C.R.C. #4491 and Cert. Surveys L. 178 P. 5 and L. 197 P. 11. Iron pipe is 6.5' North and 1.8' East of the intersection of 1/4 lines. Accepted iron pipe as Center of Section.


K.C. Witness Map	L.C.R.C. #4491
Face 12" Oak SW 52.4 (m. 53.05' to C/L)	Nail in South side 30" Maple N70°W 58.85' (m. 54.20')
Face 24" Oak NW 53.42' (m. 54.20' to C/L)	Nail and tag in North side 16" Maple S65°W 52.90' (m. 53.05')
	Spike in North side 10" Apple Tree S 65°E 49.70' (m. 49.53')
	Iron pipe West 33.00' (m. 33.40')

The selected location is accepted by me and is generally accepted by professional surveyors as the best available evidence of the position of the original corner.

C. Description of monument for corner and accessories established to perpetuate locating the position of the corner:

H-8 Replaced Iron Pipe with a Standard Kent County Monument

- Nail & K.C. remon. tag on S side 30" Maple N 70° W 54.20'
- Nail & K.C. remon. tag on N side 16" Maple S 65° W 53.05'
- Nail & K.C. remon. tag on N side 10" Apple S 65° E 49.53'
- Nail & K.C. remon. tag on NE side 6" Apple N 70° E 44.66'
- 3/4" iron pipe West 33.40'
- C/L of gravel road running N-S, West 7'
- S edge of drive to apple orchard

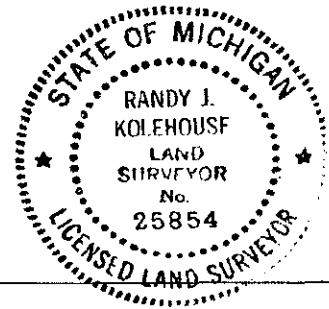

Signed by Randy J. Kolehouse
EARTH TECH

Date 11/18/98

Surveyor's Michigan License No. 25854