

\$7.00  
\$2.00

EAR 08 1983

**LAND CORNER RECORDATION CERTIFICATE**  
**Filing Requirement of Act 74, Mich. P.A. 1970**  
**KENT COUNTY REMONUMENTATION**

For corners in

SECTION

Kent (County)	Located in:	Grattan Township	Corner Code #
1. Public Land Survey	T <u>8N</u> R <u>9W</u>		<u>H-9</u>
	T _____ R _____		_____
	T _____ R _____		_____
	T _____ R _____		_____
2. Property Controlling in Section	S _____ T _____ R _____		_____
	S _____ T _____ R _____		_____
3. Miscellaneous Property in Sec.	S _____ T _____ R _____		_____
	S _____ T _____ R _____		_____

STATE OF MICHIGAN  
 COUNTY OF KENT  
 RECEIVED FOR RECORD  
 30 DEC 14 AM 8:00  
 REG. OF DEEDS  
*Luigi Standa*

10979

Register of Deeds Stamp & File Number


4. Lot No. \_\_\_\_\_, Recorded Plat \_\_\_\_\_  
 5. Private Claims \_\_\_\_\_

I, Randy Kolehouse, in a field survey on February 26 19 98, do hereby certify that under requirements of P.A. 74 Michigan P.A. of 1970, the corner points mentioned in lines 1 and 2 above were in conformance with regulations and rules therefore as required in the current manual of survey instructions of the United States Department of the interior, Bureau of Land Management or by a decree of a Court of Law and/or that the corner points mentioned in lines 3, 4 and 5 above were in conformance with the rules of the Michigan Board of Land Surveyors or by a Decree of a Court of Law; established, re-established, monumented, re-monumented, recovered, found as expressed below:

**NOTE: Not more than 4 corners, all in the same town and range, may be recorded on this certificate.**

A. Description of original monument and accessories and/or subsequent restoration:

H-9	1837	G.L.O. Notes	Cathcart	Set Post
	1956	Witness Map	K.C. Surveyor	3/4" Iron
	1983	L.C.R.C. #3302	Glaza & Associates	Iron
	1988	L.C.R.C. #4917	C. Marschall	Fnd. 3/4" Iron Pipe / Set K.C. Monument
	1991	L.C.R.C. #5870	William Byl	K.C. Monument

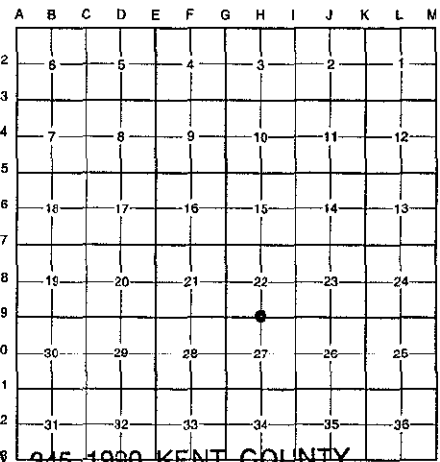

P.A. 345-1990 KENT COUNTY  
 PEER APPROVED 9/24/98  
 CHAIRMAN *Handwritten Signature*

This corner was originally approved by the Kent County Remonumentation Peer Group and monumented by C. Marschall on 11/3/88 and was recorded per L.C.R.C. #4917.

B. Description of corner evidence found and/or method applied in restoring or reestablishing corner:

H-9 Found a Standard Kent County Monument at the C/L intersection of 6 Mile Road (gravel) running East and West and Scalley Road (gravel) running North, on line of a tree row running South, per L.C.R.C.'s #4917 and #5870 as set by C. Marschall in place of a 3/4" iron pipe he found which checked L.C.R.C. #3302 and the K.C. Surveyor's records.

L.C.R.C. #4917

L.C.R.C. #5870

Nail & KC remon tag in E side 60' ash N7° W 58.10'  
 Nail & KC remon tag in S side 6" oak N61°W 55.33'  
 Nail & KC remon tag in E side 10" hickory 3' high S1° W 56.13'  
 Nail & KC remon tag in NE side 36" ash S39°E 38.91'  
 3/8" iron rod N70°E 12.94'

Nail & KC Remon. tag E. side 60" Ash N07°W 58.18'  
 Nail & KC Remon. tag E. side 6" Oak N51°W 55.36' (m. 55.35')  
 Nail & KC Remon. tag E. side 12" Hickory (3' high) S01°W 56.31' (m. 56.24')  
 Nail & KC Remon. tag NE side 36" Ash S39°E 38.58' (m. 38.73')  
 3/8" Iron rod N70°E 12.94' (m. 12.90')


The selected location is accepted by me and is generally accepted by professional surveyors as the best available evidence of the position of the original corner.

C. Description of monument for corner and accessories established to perpetuate locating the position of the corner:

H-9 Standard Kent County Monument

Nail & K.C. remon. tag on E side 60" Oak N 07° W 58.18'  
 Nail & K.C. remon. tag on E side 6" Oak N 61° W 55.35'  
 Nail & K.C. remon. tag on E side 12" Hickory S 01° W 56.24'  
 Nail & K.C. remon. tag on NE side 36" Ash S 39° E 38.73'  
 Nail & K.C. remon. tag on W side 6" Ash N 40° E 46.93'  
 Nail & K.C. remon. tag on N side 14" Ash S 65° W 47.52'

On C/L "X" of gravel roads running N-E-W  
 On tree row running South

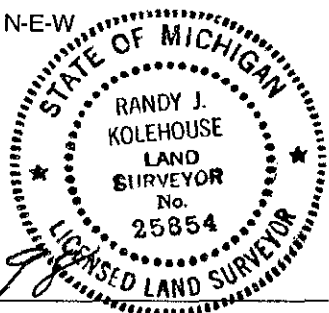

Signed by *Randy J. Kolehouse*  
 EARTH TECH

Date 9-30-98

Surveyor's Michigan License No. 25854