

**SURVEY & REMONUMENTATION**

\$7.00  
\$2.00

MAR 08 1999

**LAND CORNER RECORDATION CERTIFICATE**  
Filing Requirement of Act 74, Mich. P.A. 1970  
KENT COUNTY REMONUMENTATION


STATE OF MICHIGAN  
COUNTY OF KENT  
RECEIVED FOR RECORD  
38 DEC 14 AM 8:00  
REG. OF DEEDS  
*Luci Standa*

For corners in	<b>SECTION</b>	Located in:	Grattan Township	Corner Code #
<u>Kent</u>				
(County)				
1. Public Land Survey	T <u>8N</u> R <u>9W</u>		<u>H-10</u>	
	T _____ R _____		_____	
	T _____ R _____		_____	
	T _____ R _____		_____	
2. Property Controlling in Section	S _____ T _____ R _____		_____	
	S _____ T _____ R _____		_____	
3. Miscellaneous Property in Sec.	S _____ T _____ R _____		_____	
	S _____ T _____ R _____		_____	

**11047**

Register of Deeds Stamp & File Number

4. Lot No. \_\_\_\_\_, Recorded Plat \_\_\_\_\_  
5. Private Claims \_\_\_\_\_

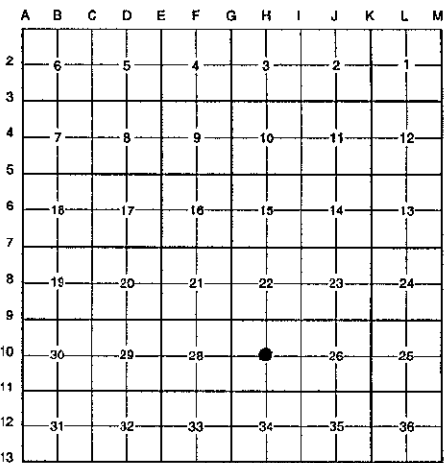

I, Randy Kolehouse, in a field survey on March 26 19 98, do hereby certify that under requirements of P.A. 74 Michigan P.A. of 1970, the corner points mentioned in lines 1 and 2 above were in conformance with regulations and rules therefore as required in the current manual of survey instructions of the United States Department of the interior, Bureau of Land Management or by a decree of a Court of Law and/or that the corner points mentioned in lines 3, 4 and 5 above were in conformance with the rules of the Michigan Board of Land Surveyors or by a Decree of a Court of Law; established, re-established, monumented, re-monumented, recovered, found as expressed below:

**NOTE: Not more than 4 corners, all in the same town and range, may be recorded on this certificate.**

A. Description of original monument and accessories and/or subsequent restoration:

H-10	This corner was not originally set by the G.L.O.		
N/A	Witness Map	K.C. Surveyor	Iron
1944	Notes	Williams & Works	Iron
1992	L.C.R.C. #6560	John Bueche	Fnd. Iron / Set K.C. Monument at Int. of 1/4 Lines

B. Description of corner evidence found and/or method applied in restoring or reestablishing corner:

H-10 Found a Standard Kent County Monument 4' West of a fence line running North and South 125' ± West of the East edge of a field as set by John Bueche at the intersection of 1/4 lines per L.C.R.C. #6560. K.C. monument is 6.1' North and 4.15' East of the intersection of 1/4 lines. Accepted monument as Center of Section.

L.C.R.C. #6560


P.A. 345 1990 KENT COUNTY  
PEER APPROVED 12/3/98  
CHAIRMAN *Harry Huber*

- Nail & K.C. Remon. Tag in S side 10" Ash S 65° W 8.25' (m. 8.23')
- Nail & K.C. Remon. Tag in E side 8" dbl. Ash S 10° W 31.52' (m. 31.49')
- Nail & K.C. Remon. Tag in W side 10" Ash N 10° W 14.35' (m. 14.37')
- Nail & K.C. Remon. Tag in N side 14" Ash N 45° E 32.07' (m. 32.10')
- Nail & K.C. Remon. Tag in N side 16" Maple S 80° E 19.07' (m. 19.12')

The selected location is accepted by me and is generally accepted by professional surveyors as the best available evidence of the position of the original corner.

C. Description of monument for corner and accessories established to perpetuate locating the position of the corner:

- H-10 Standard Kent County Monument
- Nail & K.C. remon. tag on S side 10" Ash S 65° W 8.23'
- Nail & K.C. remon. tag on E side 8" Dbl. Ash S 10° W 31.49'
- Nail & K.C. remon. tag on W side 10" Ash N 10° W 14.37'
- Nail & K.C. remon. tag on N side 14" Ash N 45° E 32.10'
- Nail & K.C. remon. tag on N side 16" Maple S 80° E 19.12'
- Fence line running N-S, East 4.0'
- East edge of field, East 125' ±

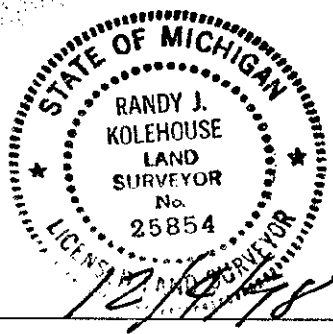

Signed by *Randy J. Kolehouse* Date 12/18/98  
EARTH TECH

Surveyor's Michigan License No. 25854