

\$7.00
\$2.00

SEP 08 1999

LAND CORNER RECORDATION CERTIFICATE
Filing Requirement of Act 74, Mich. P.A. 1970
KENT COUNTY REMONUMENTATION

For corners in SECTION
Kent (County) Located in: Grattan Township Corner Code #

1. Public Land Survey	T <u>8N</u> R <u>9W</u>	<u>H-11</u>
	T _____ R _____	_____
	T _____ R _____	_____
	T _____ R _____	_____
2. Property Controlling in Section	S _____ T _____ R _____	_____
	S _____ T _____ R _____	_____
3. Miscellaneous Property in Sec.	S _____ T _____ R _____	_____
	S _____ T _____ R _____	_____

STATE OF MICHIGAN
 COUNTY OF KENT
 RECEIVED FOR RECORD
 98 DEC 14 AM 8:00
 REG. OF DEEDS
 10980
 Register of Deeds Stamp & File Number


4. Lot No. _____, Recorded Plat _____
 5. Private Claims _____

I, Randy Kolehouse, in a field survey on October 7 19 98, do hereby certify that under requirements of P.A. 74 Michigan P.A. of 1970, the corner points mentioned in lines 1 and 2 above were in conformance with regulations and rules therefore as required in the current manual of survey instructions of the United States Department of the interior, Bureau of Land Management or by a decree of a Court of Law and/or that the corner points mentioned in lines 3, 4 and 5 above were in conformance with the rules of the Michigan Board of Land Surveyors or by a Decree of a Court of Law; established, re-established, monumented, re-monumented, recovered, found as expressed below:

NOTE: Not more than 4 corners, all in the same town and range, may be recorded on this certificate.

A. Description of original monument and accessories and/or subsequent restoration:

H-11	1837	G.L.O. Notes	Cathcart	Set Post
	1944	Witness Map	K.C. Surveyor	3/4" Pipe
	1977	L.C.R.C. #966	Williams & Works	Iron in Monument Box
	1981	L.C.R.C. #2684	Jonker Land Survey	Fnd. 3/4" Iron in Mon. Box / Set K.C. Monument in Mon. Box
	1991	L.C.R.C. #5872	William Byl	K.C. Monument in Monument Box

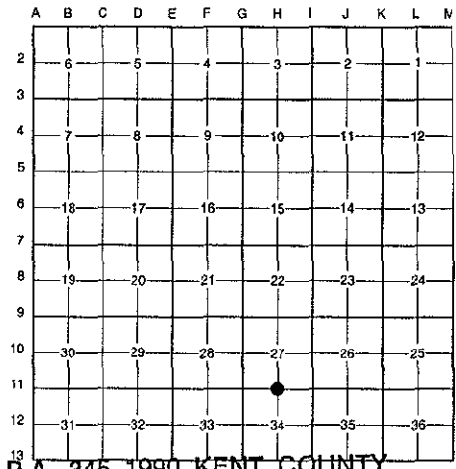

P.A. 345 1990 KENT COUNTY
 PEER APPROVED 11/24/98
 CHAIRMAN Randy Kolehouse

This corner was originally approved by the Kent County Remonumentation Peer Group and monumented by Rob Jonker on 6/12/81 and was recorded per L.C.R.C. #2684.

B. Description of corner evidence found and/or method applied in restoring or reestablishing corner:

H-11 Found a Standard Kent County Monument in a monument box 1' North of the C/L of 5 Mile Road (bit.) running East and West, on line of a tree row running North and South, per L.C.R.C.'s #2684 and #5872 as set by Rob Jonker in place of a 3/4" iron he found in a monument box over a 1" iron 1.5' below grade which checked L.C.R.C. #966 and the K.C. Surveyor's records.

L.C.R.C. #2684

Remon. tag on W side 9" Elm N 0° W 59.8'
 Remon. tag on W side 12" Tw. Sassafras 8 43° W 108.3'
 On C/L E-W Pavement

L.C.R.C. #5872


Nail & KC Remon. tag W. side Tw. 8" Elm N 00° W 59.81' (m. 59.75')
 Nail & KC Remon. tag W. side 18" Tw. Sassafras S 43° W 108.25' (m. 108.14')
 Nail & KC Remon. tg SE side 6" Pine N 60° E 85.82' (m. 85.69')

The selected location is accepted by me and is generally accepted by professional surveyors as the best available evidence of the position of the original corner.

C. Description of monument for corner and accessories established to perpetuate locating the position of the corner:

H-11 Standard Kent County Monument in a Monument Box

Nail & K.C. remon. tag on W side 10" Elm N 00° W 59.75'
 Nail & K.C. remon. tag on W side 22" Twin Sassafras S 43° W 108.14'
 Nail & K.C. remon. tag on NE side 10" Elm S 78° E 223.71'
 Nail & K.C. remon. tag on SE side 8" Pine N 60° E 85.69'
 C/L of bit. road running E-W, South 1.0'
 On tree row running N-S

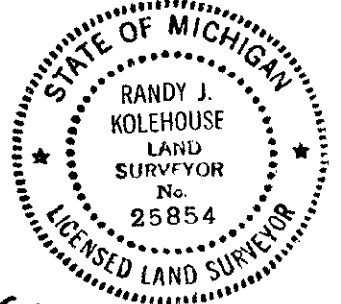

Signed by Randy J. Kolehouse
 EARTH TECH

Date 11/18/98

Surveyor's Michigan License No. 25854