

\$7.00
\$2.00

MAR 08 1998

SECTION LAND CORNER RECORDATION CERTIFICATE
Filing Requirement of Act 74, Mich. P.A. 1970
KENT COUNTY REMONUMENTATION

For corners in

Kent (County)	Located in:	Grattan Township	Corner Code #
1. Public Land Survey	T <u>8N</u>	R <u>9W</u>	<u>I-1</u>
	T _____	R _____	_____
	T _____	R _____	_____
	T _____	R _____	_____
2. Property Controlling in Section	S _____	T _____	R _____
	S _____	T _____	R _____
3. Miscellaneous Property in Sec.	S _____	T _____	R _____
	S _____	T _____	R _____


REG. OF DEEDS
38 DEC 14 AM 8:00
STATE OF MICHIGAN
COUNTY OF KENT
RECEIVED FOR RECORD

10982

Register of Deeds Stamp & File Number

4. Lot No. _____, Recorded Plat _____
5. Private Claims _____

I, Randy Kolehouse, in a field survey on January 28 19 98, do hereby certify that under requirements of P.A. 74 Michigan P.A. of 1970, the corner points mentioned in lines 1 and 2 above were in conformance with regulations and rules therefore as required in the current manual of survey instructions of the United States Department of the interior, Bureau of Land Management or by a decree of a Court of Law and/or that the corner points mentioned in lines 3, 4 and 5 above were in conformance with the rules of the Michigan Board of Land Surveyors or by a Decree of a Court of Law; established, re-established, monumented, re-monumented, recovered, found as expressed below:

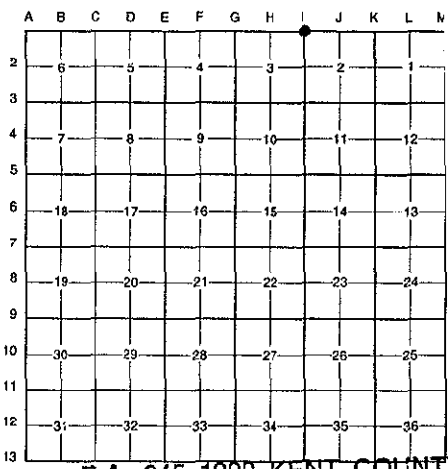

NOTE: Not more than 4 corners, all in the same town and range, may be recorded on this certificate.

A. Description of original monument and accessories and/or subsequent restoration:

I-1	1837	G.L.O. Notes	N. Brookfield	Set Post
	1887-1971	Notes	Williams & Works	Fnd. Government Corner / Set Iron
	1959	Witness Map	K.C. Surveyor	Iron
	1984	L.C.R.C. #4116	William Byl	Fnd. 1" Iron Pipe / Set K.C. Monument
	1994	L.C.R.C. #7214	Glaza & Associates	K.C. Monument

P.A. 345 1990 KENT COUNTY
PEER APPROVED 9/24/98
CHAIRMAN *[Signature]*

Note: This corner is not common with I-13, T9N, R9W.

This corner was originally approved by the Kent County Remonumentation Peer Group and monumented by William Byl on 11/3/84 and was recorded per L.C.R.C. #4116.

B. Description of corner evidence found and/or method applied in restoring or reestablishing corner:

I-1 Found a Standard Kent County Monument on the West edge of Lincoln Lake Avenue (bit.) running North and South, on line of a tree row running East, per L.C.R.C.'s #4116 and #7214 as set by William Byl in place of a 1" iron pipe he found 136.88' West of a concrete monument at the SE corner of Section 34 which checked the 1887-1971 notes of Williams & Works and the K.C. Surveyor's records.

L.C.R.C. #4116

L.C.R.C. #7214

SE cor. brick veneer garage, Hse. #8409 S 90 W 120.60'
NE cor. brick veneer, Hse. #8409 N 55 W 144.00'
Nail & tag, W sd. Power pole S 35 W 45.66'
Nail & tag, N sd. Tw. 12" Hickory S 50 E 84.00'
Nail & tag, E sd. 9" corner fence post N 00 E 117.19'

SE corner brick veneer garage, House #8409 S90°W 120.56' (m. 120.62')
NE corner brick veneer house, House #8409 N57°W 143.97'
Nail & K.C. remon tag in E side P. pole S33°W 45.69'
Nail & K.C. remon tag in E side 9" corner fence post N02°W 117.30' (m. 117.34')
Nail & K.C. remon tag in N side 22" Poplar S57°E 55.64'
Harrison Mon. (SE cor, Sec 34, T9N, R9W) East 136.86'


The selected location is accepted by me and is generally accepted by professional surveyors as the best available evidence of the position of the original corner.

C. Description of monument for corner and accessories established to perpetuate locating the position of the corner:

I-1 Standard Kent County Monument

SE cor. brick veneer garage, House #8409, S 90° W 120.62'
NE cor. brick veneer house, House #8409, N 57° W 143.97'
Nail & K.C. remon. tag on E side P. pole S 33° W 45.69'
Nail & K.C. remon. tag on E side 9" corner post N 02° W 117.34'
Nail & K.C. remon. tag on N side 22" Poplar S 57° E 55.64'

On West edge of bit. road running N-S
On tree row running E
K.C. Mon, I-13, T9N, R9W, 136.86'

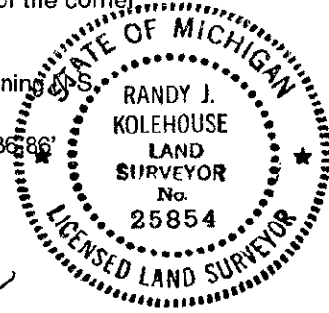

Signed by *[Signature]*
EARTH TECH

Date 9-30-98

Surveyor's Michigan License No. 25854