

WITNEY & REYNOLDS  
 7.00  
 5.00  
 1988-08-1899

**LAND CORNER RECORDATION CERTIFICATE**  
**Filing Requirement of Act 74, Mich. P.A. 1970**  
**KENT COUNTY REMONUMENTATION**


For corners in SECTION  
Kent  
 (County)

Located in: Grattan Township Corner Code #  
 1. Public Land Survey T 8N R 3W 1-2  
 T \_\_\_\_\_ R \_\_\_\_\_  
 T \_\_\_\_\_ R \_\_\_\_\_  
 T \_\_\_\_\_ R \_\_\_\_\_  
 2. Property Controlling S \_\_\_\_\_ T \_\_\_\_\_ R \_\_\_\_\_  
 in Section S \_\_\_\_\_ T \_\_\_\_\_ R \_\_\_\_\_  
 3. Miscellaneous S \_\_\_\_\_ T \_\_\_\_\_ R \_\_\_\_\_  
 Property in Sec. S \_\_\_\_\_ T \_\_\_\_\_ R \_\_\_\_\_

STATE OF MICHIGAN  
 COUNTY OF KENT  
 RECEIVED FOR RECORD  
 98 OCT 23 AM 9:59  
 REG. OF DEEDS  
*Lucy Standa*

**10881**  
 Register of Deeds Stamp & File Number

4. Lot No. \_\_\_\_\_, Recorded Plat \_\_\_\_\_  
 5. Private Claims \_\_\_\_\_

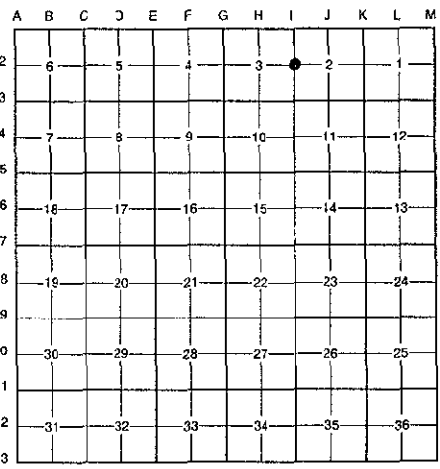

I, Randy Kolehouse, in a field survey on February 6 19 98, do hereby certify that under requirements of P.A. 74 Michigan P.A. of 1970, the corner points mentioned in lines 1 and 2 above were in conformance with regulations and rules therefore as required in the current manual of survey instructions of the United States Department of the interior, Bureau of Land Management or by a decree of a Court of Law and/or that the corner points mentioned in lines 3, 4 and 5 above were in conformance with the rules of the Michigan Board of Land Surveyors or by a Decree of a Court of Law; established, re-established, monumented, re-monumented, recovered, found as expressed below:

**NOTE: Not more than 4 corners, all in the same town and range, may be recorded on this certificate.**

**A. Description of original monument and accessories and/or subsequent restoration:**

I-2	1837	G.L.O. Notes	Cathcart	Set Post
	1938-59	Witness Map	K.C. Surveyor	1" Iron in Monument Box
	1971	Notes	Williams & Works	1" Iron in Monument Box
	1983	L.C.R.C. #3303	Glaza & Associates	1" Iron in Monument Box
	1985	L.C.R.C. #4185	R. Kolehouse	Fnd. 1" Iron / Set K.C. Monument in Mon. Box

This corner was originally approved by the Kent County Remonumentation Peer Group and monumented by R. Kolehouse on 3/9/85 and was recorded per L.C.R.C. #4185.

**B. Description of corner evidence found and/or method applied in restoring or reestablishing corner:**

I-2 Found a Standard Kent County Monument at the C/L intersection of Lincoln Lake Road (bit.) running North and South and Heffron Road (bit.) running East and West per L.C.R.C. #4185 as set by Randy Kolehouse in place of a 1" iron he found in a monument box which checked L.C.R.C. #3303, the notes of Williams & Works, and the K.C. Surveyor's records.


L.C.R.C. #4185	L.C.R.C. #5873
NE cor house fdn S 42° W 151.25'	NE cor. house fdn. S42°W 151.15' (m. 151.20')
C/L R/W marker S 15° E 121.75'	C/L R/W marker S15°E 121.85' (m. 121.91')
C/L R/W marker N 20° E 120.92'	C/L R/W marker N20°E 120.92' (m. 120.93')
Nail & K.C. Remon. tag in E. side P.Pole S 25° W 96.75'	Nail & KC Remon. tag E. side P. Pole S25°W 96.55' (m. 96.52')

The selected location is accepted by me and is generally accepted by professional surveyors as the best available evidence of the position of the original corner.

**C. Description of monument for corner and accessories established to perpetuate locating the position of the corner:**

I-2 Standard Kent County Monument  
 NE cor. hse. fndn. S 42° W 151.20'  
 C/L R/W marker S 15° E 121.91'  
 C/L R/W marker N 20° E 120.93'  
 Nail & K.C. remon. tag on E side P. pole S 25° W 96.52'  
 Survey marker N 35° E 57.79'  
 On C/L "X" of bit. roads running N-S & E-W

P.A. 345 1990 KENT COUNTY  
 PEER APPROVED 6/25/98  
 CHAIRMAN Randy Kolehouse

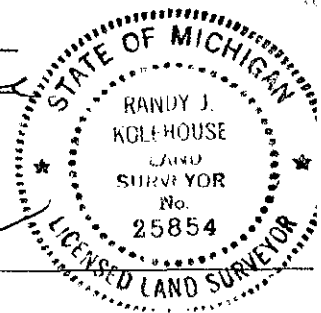

Signed by Randy J. Kolehouse Date 9-1-98

Surveyor's Michigan License No. 25854