

SURVEY & REMONUMENTATION
 \$7.00
 \$2.00
 MAR 08 1999

LAND CORNER RECORDATION CERTIFICATE
 Filing Requirement of Act 74, Mich. P.A. 1970
 KENT COUNTY REMONUMENTATION


For corners in Kent SECTION _____ Located in: Gratatan Township Corner Code # _____
 (County)

- 1. Public Land Survey T 8N R 9W Corner Code # I-3
 T _____ R _____
 T _____ R _____
 T _____ R _____
- 2. Property Controlling in Section S _____ T _____ R _____
 S _____ T _____ R _____
- 3. Miscellaneous Property in Sec. S _____ T _____ R _____
 S _____ T _____ R _____

STATE OF MICHIGAN
 COUNTY OF KENT
 RECEIVED FOR RECORD
 38 OCT 23 AM 9:59
 REG. OF DEEDS
 10882
 Register of Deeds Stamp & File Number

- 4. Lot No. _____, Recorded Plat _____
- 5. Private Claims _____

I, Randy Kolehouse, in a field survey on February 6 19 98, do hereby certify that under requirements of P.A. 74 Michigan P.A. of 1970, the corner points mentioned in lines 1 and 2 above were in conformance with regulations and rules therefore as required in the current manual of survey instructions of the United States Department of the interior, Bureau of Land Management or by a decree of a Court of Law and/or that the corner points mentioned in lines 3, 4 and 5 above were in conformance with the rules of the Michigan Board of Land Surveyors or by a Decree of a Court of Law; established, re-established, monumented, re-monumented, recovered, found as expressed below:

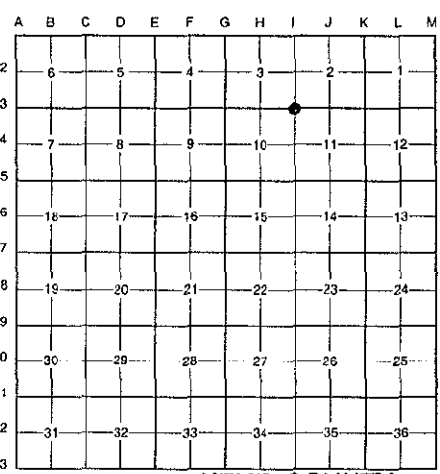

NOTE: Not more than 4 corners, all in the same town and range, may be recorded on this certificate.

A. Description of original monument and accessories and/or subsequent restoration:

I-3	1837	G.L.O. Notes	Cathcart	Set Post
	N/A	Witness Map	K.C. Surveyor	Iron
	1979	L.C.R.C. #1292	Williams & Works	Iron
	1981	L.C.R.C. #2016	Jonker Land Survey	Fnd. 3/4" Iron / Set K.C. Monument
	1991	L.C.R.C. #5874	William Byl	K.C. Monument

P.A. 345 1990 KENT COUNTY
 PEER APPROVED 6/25/98
 CHAIRMAN [Signature]

This corner was originally approved by the Kent County Remonumentation Peer Group and monumented by Rob Jonker on 6/16/81 and was recorded per L.C.R.C. #2016.

B. Description of corner evidence found and/or method applied in restoring or reestablishing corner:

I-3 Found a Standard Kent County Monument 2' East of the C/L of Lincoln Lake Road (bit.) running North and South, on line of a brush line running East and an occupation line running West, per L.C.R.C.'s #2016 and #5874 as set by Rob Jonker in place of a 3/4" iron he found at grade over a 3/4" iron 16" below grade which checked L.C.R.C. #1292 and the K.C. Surveyor's records.

L.C.R.C. #2016 L.C.R.C. #5874

Remon. tag on W. side 22" Maple S15°E 223.25'	Nail & KC Remon. tag W. side 38" Maple S15°E 223.25' (m. 223.21')
Remon. tag on N side fe. Post East 33.4'	Nail & KC Remon. tag N. side fence post (leaning East) N90°E 33.6' (m. 33.62')
C/L E. end 12" conc. E-W road culvert N75°E 15.33'	Cut "X" E. end 15" conc. E-W road culvert N75°E 15.21' (m. 15.30')
C/L W. end 12" conc. E-W road culvert N75°W 19.65'	Cut "X" W. end 15" conc. E-W road culvert N75°W 19.50' (m. 19.53')

The selected location is accepted by me and is generally accepted by professional surveyors as the best available evidence of the position of the original corner.

C. Description of monument for corner and accessories established to perpetuate locating the position of the corner:

- I-3 Standard Kent County Monument
 - Nail & K.C. remon. tag on W side 36" Maple S 15° E 223.21'
 - Nail & K.C. remon. tag on N side fence post (leaning East) N 90° E 33.62'
 - "X" cut E end 15" conc. culvert N 75° E 15.30'
 - "X" cut W end 15" conc. culvert N 75° W 19.53'
 - Nail & K.C. remon. tag on E side 12" Maple N 20° E 120.06'
 - C/L of bit. road running N-S, West 2'
 - On brush line running E
 - On occupation line running W



Signed by Randy J. Kolehouse Date 9-1-98
 EARTH TECH

Surveyor's Michigan License No. 25854