

SURVEY &
 REMONUMENTATION
 \$7.00
 \$2.00
 MAR 08 1999

LAND CORNER RECORDATION CERTIFICATE
Filing Requirement of Act 74, Mich. P.A. 1970
KENT COUNTY REMONUMENTATION


STATE OF MICHIGAN
 COUNTY OF KENT
 RECEIVED FOR RECORD
 38 OCT 23 AM 10:00
 REG. OF DEEDS
W. J. Kolehouse

For corners in SECTION

Kent (County)	Located in: Grattan Township	Corner Code #
1. Public Land Survey	T <u>8N</u> R <u>9W</u>	<u>1-4</u>
	T _____ R _____	_____
	T _____ R _____	_____
	T _____ R _____	_____
2. Property Controlling in Section	S _____ T _____ R _____	_____
	S _____ T _____ R _____	_____
3. Miscellaneous Property in Sec.	S _____ T _____ R _____	_____
	S _____ T _____ R _____	_____
4. Lot No. _____, Recorded Plat _____		
5. Private Claims _____		

10883
 Register of Deeds Stamp & File Number

I, Randy Kolehouse, in a field survey on February 6 19 98, do hereby certify that under requirements of P.A. 74 Michigan P.A. of 1970, the corner points mentioned in lines 1 and 2 above were in conformance with regulations and rules therefore as required in the current manual of survey instructions of the United States Department of the interior, Bureau of Land Management or by a decree of a Court of Law and/or that the corner points mentioned in lines 3, 4 and 5 above were in conformance with the rules of the Michigan Board of Land Surveyors or by a Decree of a Court of Law; established, re-established, monumented, re-monumented, recovered, found as expressed below:

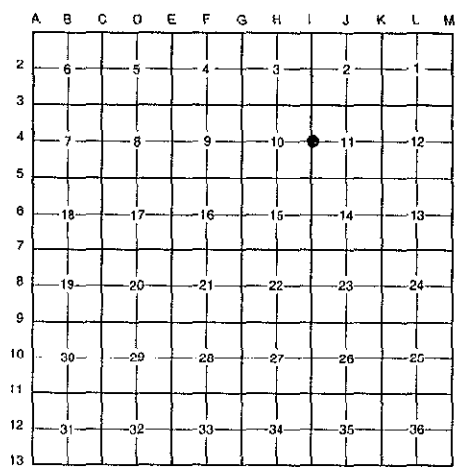

NOTE: Not more than 4 corners, all in the same town and range, may be recorded on this certificate.

A. Description of original monument and accessories and/or subsequent restoration:

I-4	1837	G.L.O. Notes	Cathcart	Set Post
	1974	L.C.R.C. #733	Medema, Van Kooten & Assoc.	N/A
	1979	L.C.R.C. #1292	Williams & Works	"T" Iron
	1985	L.C.R.C. #4218	R. Kolehouse	Fnd. iron / Set K.C. Monument
	1991	L.C.R.C. #5875	William Byl	K.C. Monument

This corner was originally approved by the Kent County Remonumentation Peer Group and monumented by Randy Kolehouse on 5/11/85 and was recorded per L.C.R.C. #4218.

B. Description of corner evidence found and/or method applied in restoring or reestablishing corner:

I-4 Found a Standard Kent County Monument 3' East of the C/L of Lincoln Lake Road (bit.) running North and South and 6' North of the C/L of Strotheide Road (gravel) running East per L.C.R.C.'s #4218 and #5875 as set by Randy Kolehouse per L.C.R.C. #733.

L.C.R.C. #4218

L.C.R.C. #5875


Nail & K.C. Remon. tag in S. side 40" Maple N 75° E 44.61'	Nail & KC Remon. tag S. side 40" Maple N75°E 44.58' (m. 44.57')
Nail & K.C. Remon. tag in E. side 6" Hickory N 25° W 91.40'	Nail & KC Remon. tag E. side 8" Hickory N25°W 91.43' (m. 91.40')
Nail & K.C. Remon. tag in S. side Tri 8" Maple N 75° W 45.93'	Nail & KC Remon. tag S. side Tri. 10" Maple N75°W 45.82' (m. 45.74')
Nail & K.C. Remon. tag in E. side 22" Hickory S 20° W 125.93'	Nail & KC Remon. tag E. side 24" Hickory S20°W 126.02' (m. 126.03')
	SW cor. hse. fdn. N60°E 98.27' (m. 98.24')

The selected location is accepted by me and is generally accepted by professional surveyors as the best available evidence of the position of the original corner.

C. Description of monument for corner and accessories established to perpetuate locating the position of the corner:

- I-4 Standard Kent County Monument
- Nail & K.C. remon. tag on S side 40" Maple N 75° E 44.57'
 - Nail & K.C. remon. tag on E side 8" Hickory N 25° W 91.40'
 - Nail & K.C. remon. tag on S side triple 10" Maple N 75° W 45.74'
 - Nail & K.C. remon. tag on E side 24" Hickory S 20° W 126.03'
 - SW cor. hse. fdn. N 60° E 98.24'
 - C/L of bit. road running N-S, West 3'
 - C/L of gravel road running E, South 6'

P.A. 345 1990 KENT COUNTY
 PEER APPROVED 6/25/98
 CHAIRMAN Randy Kolehouse

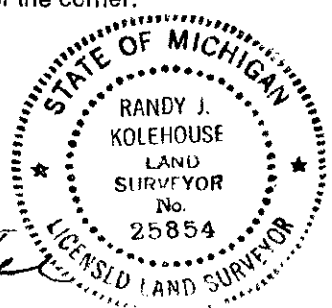

Signed by Randy J. Kolehouse Date 9-1-98

Surveyor's Michigan License No. 25854