

SURVEY & REMONUMENTATION

\$7.00 APR 08 1999
\$2.00

SECTION

LAND CORNER RECORDATION CERTIFICATE
Filing Requirement of Act 74, Mich. P.A. 1970
KENT COUNTY REMONUMENTATION

STATE OF MICHIGAN
COUNTY OF KENT
RECEIVED FOR RECORDS
38 OCT 23 AM 10:00
REG. OF DEEDS
Luci Standa

For corners in

Kent (County)	Located in:	Grattan Township	Corner Code #
1. Public Land Survey	T <u>8N</u>	R <u>9W</u>	<u>1-5</u>
	T _____	R _____	_____
	T _____	R _____	_____
	T _____	R _____	_____
2. Property Controlling in Section	S _____	T _____	R _____
	S _____	T _____	R _____
3. Miscellaneous Property in Sec.	S _____	T _____	R _____
	S _____	T _____	R _____

10884

Register of Deeds Stamp & File Number


4. Lot No. _____, Recorded Plat _____
5. Private Claims _____

I, Randy Kolehouse, in a field survey on February 6 19 98, do hereby certify that under requirements of P.A. 74 Michigan P.A. of 1970, the corner points mentioned in lines 1 and 2 above were in conformance with regulations and rules therefore as required in the current manual of survey instructions of the United States Department of the interior, Bureau of Land Management or by a decree of a Court of Law and/or that the corner points mentioned in lines 3, 4 and 5 above were in conformance with the rules of the Michigan Board of Land Surveyors or by a Decree of a Court of Law; established, re-established, monumented, re-monumented, recovered, found as expressed below:

NOTE: Not more than 4 corners, all in the same town and range, may be recorded on this certificate.

A. Description of original monument and accessories and/or subsequent restoration:

I-5	1837	G.L.O. Notes	Cathcart	Set Post
	1907-60	Notes	Williams & Works	Stone & Iron
	1965	Witness Map	K.C. Surveyor	Stone & Iron
	1974	L.C.R.C. #733	Medema, Van Kooten & Assoc.	Iron
	1981	L.C.R.C. #1856	Williams & Works	"T" Iron Above Pointed Stone
	1985	L.C.R.C. #4217	R. Kolehouse	Fnd. "T" Iron / Set K.C. Monument Above Pointed Stone
	1991	L.C.R.C. #5876	W. Byl	K.C. Monument Above Pointed Stone

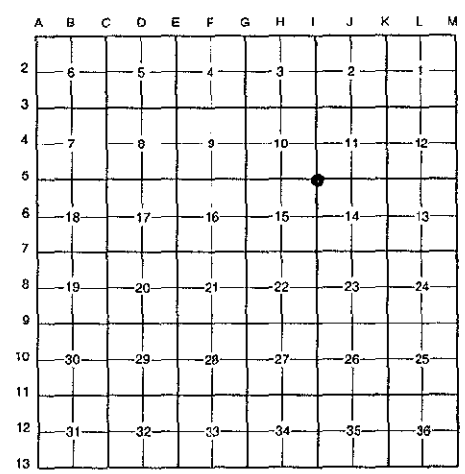

This corner was originally approved by the Kent County Remonumentation Peer Group and monumented by Randy Kolehouse on 5/11/85 and was recorded per L.C.R.C. #4217.

B. Description of corner evidence found and/or method applied in restoring or reestablishing corner:

I-5 Found a Standard Kent County Monument .5' East of the C/L of Lincoln Lake Road (bit.) running North and South and 6' ± South of the C/L of 8 Mile Road (gravel) running West per L.C.R.C.'s #4217 and #5876 as set by Randy Kolehouse in place of a "T" iron he found above a pointed stone which checked L.C.R.C. #1856.

L.C.R.C. #4217

L.C.R.C. #5876

Nail & K.C. Remon. tag in SE side 12" Oak N 30° E 50.69'	Nail & KC Remon. tag, SW side 12" Hickory S40°E 44.40' (m. 44.35')
Nail & K.C. Remon. tag in SW side 12" Hickory S 40° E 44.30'	Nail & KC Remon. tag NW side 6" Oak S50°W 47.64' (m. 47.61')
Nail & K.C. Remon. tag in NW side 6" Oak S 50° W 47.60'	Nail & KC Remon. tag N. side 18" Oak S80°W 67.50' (m. 67.51')
Nail & K.C. Remon. tag in N. side 16" Oak S 80° W 67.53'	Nail & KC Remon. tag SE side 12" Oak N50°E 60.15' (m. 60.13')
	Nail & KC Remon. tag SE side 10" Hickory S85°E 52.64' (m. 52.62')


The selected location is accepted by me and is generally accepted by professional surveyors as the best available evidence of the position of the original corner.

C. Description of monument for corner and accessories established to perpetuate locating the position of the corner:

I-5 Standard Kent County Monument

Nail & K.C. remon. tag on SW side 12" Hickory S 40° E 44.35'	C/L of bit. road running N-S, West .5'
Nail & K.C. remon. tag on NW side 6" Oak S 50° W 47.61'	C/L of gravel road running W, North 6'
Nail & K.C. remon. tag on N side 18" Oak S 80° W 67.51'	
Nail & K.C. remon. tag on SE side 12" Oak N50° E 60.13'	
Nail & K.C. remon. tag on SE side 10" Hickory S 85° E 52.62'	

Signed by Randy J Kolehouse Date 9-1-98
EARTH TECH
Surveyor's Michigan License No. 25854

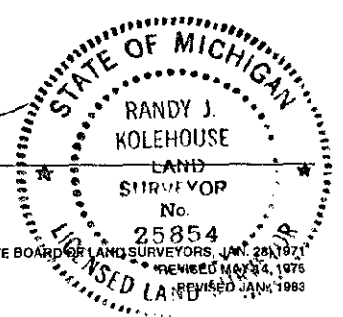

P.A. 345 1990 KENT COUNTY FORM APPROVED BY MICHIGAN STATE BOARD OF LAND SURVEYORS, JAN. 28, 1971
PEER APPROVED 6/25/98
CHAIRMAN Randy Huber
REVISED JAN. 1993