

\$7.00
\$2.00
MAR 08 1999

LAND CORNER RECORDATION CERTIFICATE
Filing Requirement of Act 74, Mich. P.A. 1970
KENT COUNTY REMONUMENTATION

For corners in SECTION
Kent
 (County)


Located in: Grattan Township Corner Code #
 T 8N R 9W I-6
 T _____ R _____
 T _____ R _____
 T _____ R _____
 S _____ T _____ R _____
 S _____ T _____ R _____
 S _____ T _____ R _____
 S _____ T _____ R _____

STATE OF MICHIGAN
 COUNTY OF KENT
 RECEIVED FOR RECORD
 98 OCT 23 AM 10:00
 REG. OF DEEDS
Rob Jonker

10885
 Register of Deeds Stamp & File Number

4. Lot No. _____, Recorded Plat _____
 5. Private Claims _____

I, Randy Kolehouse, in a field survey on February 6 19 98, do hereby certify that under requirements of P.A. 74 Michigan P.A. of 1970, the corner points mentioned in lines 1 and 2 above were in conformance with regulations and rules therefore as required in the current manual of survey instructions of the United States Department of the Interior, Bureau of Land Management or by a decree of a Court of Law and/or that the corner points mentioned in lines 3, 4 and 5 above were in conformance with the rules of the Michigan Board of Land Surveyors or by a Decree of a Court of Law; established, re-established, monumented, re-monumented, recovered, found as expressed below:

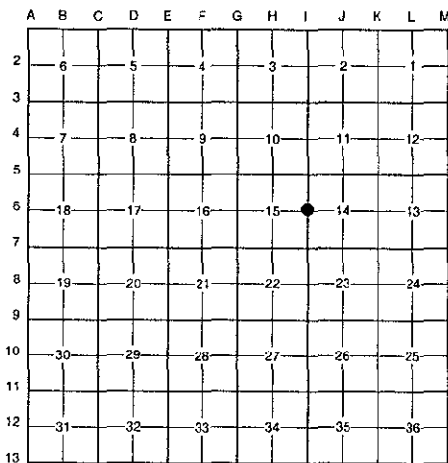

NOTE: Not more than 4 corners, all in the same town and range, may be recorded on this certificate.

A. Description of original monument and accessories and/or subsequent restoration:

I-6	1837	G.L.O. Notes	Cathcart	Set Post
	1965	Witness Map	K.C. Surveyor	1" Iron in Monument Box
	1973	L.C.R.C. #504	Williams & Works	1" Iron in Monument Box
	1981	L.C.R.C. #2017	Jonker Land Survey	Fnd. 1" Iron in Mon. Box / Set K.C. Monument in Mon. Box
	1991	L.C.R.C. #5877	William Byl	K.C. Monument

This corner was originally approved by the Kent County Remonumentation Peer Group and monumented by Rob Jonker on 6/16/81 and was recorded per L.C.R.C. #2017.

B. Description of corner evidence found and/or method applied in restoring or reestablishing corner:

I-6 Found a Standard Kent County Monument on the C/L of Lincoln Lake Road (bit.) running North and South per L.C.R.C.'s #2017 and #5877 as set by Rob Jonker in place of a 1" iron he found in a monument box which checked L.C.R.C. #504 and the K.C. Surveyor's records.


L.C.R.C. #2017	L.C.R.C. #5877
Remon. tag on N side tw. 30" Oak N87°W 28.45'	Nail & KC Remon. tag N. side Tw. 30" Oak N87°W 28.45' (m. 28.44')
Remon. tag on NE side 12" Poplar S40°E 48.21'	Nail & KC Remon. tag NE side 14" Poplar S40°E 48.37' (m. 48.38')
Remon. tag on W side 10" Pine N33°E 58.12'	Nail & KC Remon. tag W. side 12" Pine N33°E 58.09' (m. 58.04')
	Nail & KC Remon. tag NE side 12" Poplar N30°W 66.77' (m. 66.74')

The selected location is accepted by me and is generally accepted by professional surveyors as the best available evidence of the position of the original corner.

C. Description of monument for corner and accessories established to perpetuate locating the position of the corner:

- I-6 Standard Kent County Monument
 Nail & K.C. remon. tag on N side twin 30" Oak N 87° W 28.44'
 Nail & K.C. remon. tag on NE side 14" Poplar S 40° E 48.38'
 Nail & K.C. remon. tag on W side 12" Pine N 33° E 58.04'
 Nail & K.C. remon. tag on NE side 12" Poplar N30°W 66.74'
 Nail & K.C. remon. tag on S side 6" Maple S 80° E 35.02'
 On C/L of bit. road running N-S

P.A. 345 1990 KENT COUNTY
 PEER APPROVED
 CHAIRMAN

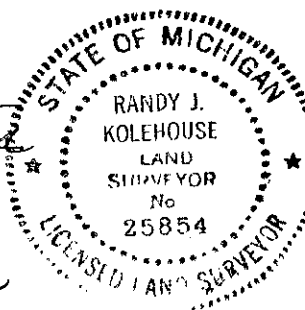

Signed by Randy J. Kolehouse Date 9-1-98
 EARTH TECH

Surveyor's Michigan License No. 25854