

\$7.00
\$2.00

FEB 08 1999

SECTION

LAND CORNER RECORDATION CERTIFICATE
Filing Requirement of Act 74, Mich. P.A. 1970
KENT COUNTY REMONUMENTATION

REG. OF DEEDS
Lucy Bond

28 OCT 23 AM 10: 00

STATE OF MICHIGAN
COUNTY OF KENT
RECEIVED FOR RECORD

For corners in


Kent (County)	Located in:	Grattan Township	Corner Code #
1. Public Land Survey	T <u>8N</u>	R <u>9W</u>	<u>I-7</u>
	T _____	R _____	_____
	T _____	R _____	_____
	T _____	R _____	_____
2. Property Controlling in Section	S _____	T _____	R _____
	S _____	T _____	R _____
3. Miscellaneous Property in Sec.	S _____	T _____	R _____
	S _____	T _____	R _____

10886

Register of Deeds Stamp & File Number

- 4. Lot No. _____, Recorded Plat _____
- 5. Private Claims _____

I, Randy Kolehouse, in a field survey on February 6 19 98, do hereby certify that under requirements of P.A. 74 Michigan P.A. of 1970, the corner points mentioned in lines 1 and 2 above were in conformance with regulations and rules therefore as required in the current manual of survey instructions of the United States Department of the interior, Bureau of Land Management or by a decree of a Court of Law and/or that the corner points mentioned in lines 3, 4 and 5 above were in conformance with the rules of the Michigan Board of Land Surveyors or by a Decree of a Court of Law; established, re-established, monumented, re-monumented, recovered, found as expressed below:

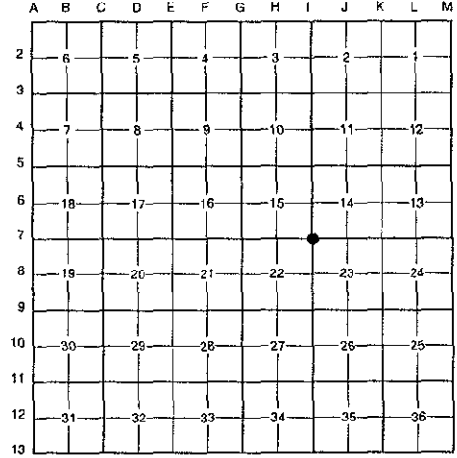

NOTE: Not more than 4 corners, all in the same town and range, may be recorded on this certificate.

A. Description of original monument and accessories and/or subsequent restoration:

I-7	1837	G.L.O. Notes	Cathcart	Set Post
	N/A	Witness Map	K.C. Surveyor	1" Iron in Monument Box
	1973	L.C.R.C. #504	Williams & Works	Monument Box
	1981	L.C.R.C. #2018	Jonker Land Survey	Fnd. 1" Iron in Mon. Box / Set K.C. Monument in Mon. Box
	1991	L.C.R.C. #5878	William Byl	K.C. Monument

This corner was originally approved by the Kent County Remonumentation Peer Group and monumented by Rob Jonker on 6/17/81 and was recorded per L.C.R.C. #2018.

B. Description of corner evidence found and/or method applied in restoring or reestablishing corner:

I-7 Found a Standard Kent County Monument at the C/L intersection of Lincoln Lake Road (bit.) running North and South and 7 Mile Road (gravel) running East and West per L.C.R.C.'s #2018 and #5878 as set by Rob Jonker in place of a 1" iron he found in a monument box which checked L.C.R.C. #504 and the K.C. Surveyor's records.

L.C.R.C. #2018

L.C.R.C. #5878

Remon. tag on Sroot of 42" Maple N80°W 159.77'
C/L E. end Conc. road culvert N33°E 56.89'


Nail & KC Remon. tag S. root 46" Maple N80°W 158.65' (m. 158.69')
Cut "X" E. end 15" conc. culvert N33°E 56.65' (m. 56.67')
Cut "X" W. end 15" conc. culvert N20°W 57.18' (m. 57.16')
SE cor. conc. block hse. Fdn. N30°W 143.48' (m. 143.46')
NE cor. steel bldg. S45°W 148.05' (m. 148.03')

The selected location is accepted by me and is generally accepted by professional surveyors as the best available evidence of the position of the original corner.

C. Description of monument for corner and accessories established to perpetuate locating the position of the corner:

- I-7 Standard Kent County Monument
- Nail & K.C. remon. tag on S side 46" Maple N 80° W 158.69'
- Nail & K.C. remon. tag on S side P. pole S 70° E 163.00'
- "X" cut E. end 15" conc. culvert N 33° E 56.67'
- "X" cut W. end 15" conc. culvert N 20° W 57.16'
- SE cor. conc. block hse. Fndn. N 30° W 143.46'
- NE cor. steel bldg. S 45° W 148.03'
- On C/L "X" of bit. road running N-S & gravel road running E-W

P.A. 345 1990 KENT COUNTY
PEER APPROVED 6/25/98
CHAIRMAN [Signature]

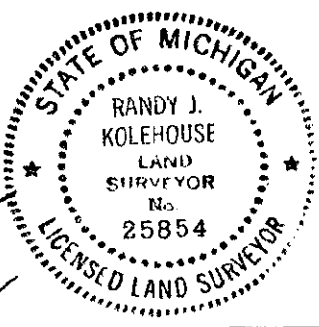

Signed by Randy J. Kolehouse Date 9-1-98
EARTH TECH

Surveyor's Michigan License No. 25854