

SURVEY &  
REMONUMENTATION

\$7.00  
\$2.00

MAR 08 1999

LAND CORNER RECORDATION CERTIFICATE  
Filing Requirement of Act 74, Mich. P.A. 1970  
KENT COUNTY REMONUMENTATION

For corners in

SECTION

Kent (County)	Located in:	Grattan Township	Corner Code #
1. Public Land Survey	T <u>8N</u>	R <u>9W</u>	<u>1-8</u>
	T _____	R _____	_____
	T _____	R _____	_____
	T _____	R _____	_____
2. Property Controlling in Section	S _____	T _____	R _____
	S _____	T _____	R _____
3. Miscellaneous Property in Sec.	S _____	T _____	R _____
	S _____	T _____	R _____
4. Lot No. _____	Recorded Plat _____		
5. Private Claims _____	_____		

STATE OF MICHIGAN  
COUNTY OF KENT  
RECEIVED FOR RECORD  
98 OCT 23 AM 10:00  
REG. OF DEEDS  
*Lucy Stoddard*

10887

Register of Deeds Stamp & File Number

I, Randy Kolehouse, in a field survey on February 6, 19 98, do hereby certify that under requirements of P.A. 74 Michigan P.A. of 1970, the corner points mentioned in lines 1 and 2 above were in conformance with regulations and rules therefore as required in the current manual of survey instructions of the United States Department of the interior, Bureau of Land Management or by a decree of a Court of Law and/or that the corner points mentioned in lines 3, 4 and 5 above were in conformance with the rules of the Michigan Board of Land Surveyors or by a Decree of a Court of Law; established, re-established, monumented, re-monumented, recovered, found as expressed below:

NOTE: Not more than 4 corners, all in the same town and range, may be recorded on this certificate.

A. Description of original monument and accessories and/or subsequent restoration:

1-8	1837	G.L.O. Notes	Cathcart	Set Post
	1880	Notes	Williams & Works	Found Stake / Set Stone
	1956	Witness Map	K.C. Surveyor	1/2" Iron
	1959	Notes	Williams & Works	Iron in Mon. Box
	1983	L.C.R.C. #3646	John Bueche	Fnd. 3/4" Iron in Mon. Box / Set K.C. Mon. in Mon. Box
	1991	L.C.R.C. #5879	William Byl	K.C. Monument in Mon. Box

This corner was originally approved by the Kent County Remonumentation Peer Group and monumented by John Bueche on 11/21/83 and was recorded per L.C.R.C. #3646.

B. Description of corner evidence found and/or method applied in restoring or reestablishing corner:

1-8 Found a Standard Kent County Monument in a monument box 2' West of the C/L of Lincoln Lake Road (bit.) running North and South, on line of a fence line and tree row running East, per L.C.R.C.'s #3646 and #5879 as set by John Bueche in place of a 3/4" iron he found in a monument box which checked the notes of Williams & Works and the K.C. Surveyor's records.

L.C.R.C. #5879

KC Remon. tag & nail E. side 12" Poplar S25°E 78.50' (m. 78.51')  
KC Remon. tag & nail S. side 14" Basswood N90°E 48.32' (m. 48.29')  
KC Remon. tag & nail W. side 4" Apple N35°E 85.90' (m. 85.93')

P.A. 345 1990 KENT COUNTY

PEER APPROVED 6/25/98


CHAIRMAN Harry Hubert

The selected location is accepted by me and is generally accepted by professional surveyors as the best available evidence of the position of the original corner.

C. Description of monument for corner and accessories established to perpetuate locating the position of the corner:

1-8 Standard Kent County Monument in a Monument Box

Nail & K.C. remon. tag on E side 12" Poplar S 25° E 78.51'  
Nail & K.C. remon. tag on S side 14" Basswood N 90° E 48.29'  
Nail & K.C. remon. tag on W side 4" Apple N 35° E 85.93'  
Nail & K.C. remon. tag on SW side 10" Basswood S 60° E 51.32'  
Rebar N 90° W 50.00'  
C/L of bit. road running N-S, East 2'  
On fence line and tree row running East

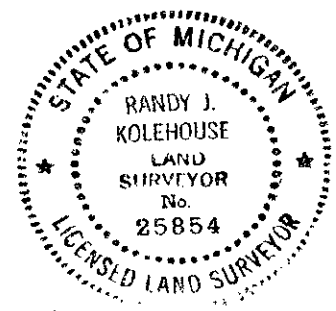

Signed by Randy J. Kolehouse Date 9-1-98  
EARTH TECH

Surveyor's Michigan License No. 25854

