

LAND SURVEY & REMONUMENTATION
 \$7.00
 \$2.00
 MAR 08 1999

LAND CORNER RECORDATION CERTIFICATE
 Filing Requirement of Act 74, Mich. P.A. 1970
 KENT COUNTY REMONUMENTATION


For corners in SECTION
Kent
 (County)

Located in: Grattan Township Corner Code #
 T 8N R 9W I-9
 T _____ R _____
 T _____ R _____
 T _____ R _____
 S _____ T _____ R _____
 S _____ T _____ R _____
 S _____ T _____ R _____
 S _____ T _____ R _____

STATE OF MICHIGAN
 COUNTY OF KENT
 RECEIVED FOR RECORD
 98 OCT 23 AM 10:00
 REG. OF DEEDS
 10888
 Register of Deeds Stamp & File Number

4. Lot No. _____, Recorded Plat _____
 5. Private Claims _____

I, Randy Kolehouse, in a field survey on February 6 19 98, do hereby certify that under requirements of P.A. 74 Michigan P.A. of 1970, the corner points mentioned in lines 1 and 2 above were in conformance with regulations and rules therefore as required in the current manual of survey instructions of the United States Department of the Interior, Bureau of Land Management or by a decree of a Court of Law and/or that the corner points mentioned in lines 3, 4 and 5 above were in conformance with the rules of the Michigan Board of Land Surveyors or by a Decree of a Court of Law; established, re-established, monumented, re-monumented, recovered, found as expressed below:

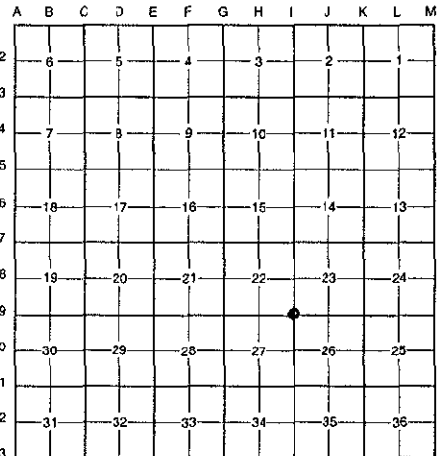

NOTE: Not more than 4 corners, all in the same town and range, may be recorded on this certificate.

A. Description of original monument and accessories and/or subsequent restoration:

I-9	1837	G.L.O. Notes	Cathcart	Set Post
	1933-65	Witness Map	K.C. Surveyor	3/4" Iron in Monument Box
	1954	Notes	Williams & Works	Iron
	1983	L.C.R.C. #3647	John Bueche	Fnd. 3/4" Iron in Mon. Box / Set K.C. Monument in Mon. Box
	1991	L.C.R.C. #5880	William Byl	K.C. Monument

This corner was originally approved by the Kent County Remonumentation Peer Group and monumented by John Bueche on 11/21/83 and was recorded per L.C.R.C. #3647.

B. Description of corner evidence found and/or method applied in restoring or reestablishing corner:

I-9 Found a Standard Kent County Monument at the C/L intersection of Lincoln Lake Road (bit.) running North and South and 6 Mile Road (bit.) running East and West per L.C.R.C.'s #3647 and #5880 as set by John Bueche in place of a 3/4" iron he found in a monument box which checked the notes of Williams & Works and the K.C. Surveyor's records.

L.C.R.C. #3647

L.C.R.C. #5880

"X" cut on conc. curb return S 20° E 48.15'
 "X" cut on conc. curb return N 70° W 46.02'
 "X" cut on conc. curb return N 20° W 47.86'


"X" cut on conc. curb return S 20° E 48.15'
 "X" cut on conc. curb return N 70° W 46.02'
 "X" cut on conc. curb return N 20° W 47.86'
 Nail & KC Remon. tag W. side P. Pole N 30° E 70.76' (m. 70.74')

The selected location is accepted by me and is generally accepted by professional surveyors as the best available evidence of the position of the original corner.

C. Description of monument for corner and accessories established to perpetuate locating the position of the corner:

I-9 Standard Kent County Monument
 "X" cut on conc. curb S 20° E 48.15'
 "X" cut on conc. curb N 70° W 46.02'
 "X" cut on conc. curb N 20° W 47.86'
 Nail & K.C. remon. tag on W side P. pole N 30° E 70.74'
 E'ly cor. conc. R/W marker S 70° W 121.38'
 On C/L "X" of bit. roads running N-S & E-W

P.A. 345 1990 KENT COUNTY
 PEER APPROVED 6/25/99
 CHAIRMAN *[Signature]*

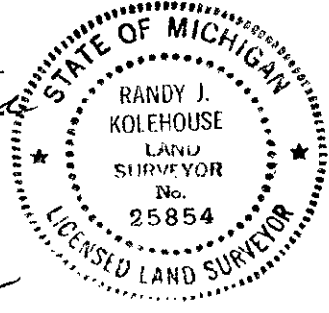

Signed by *Randy J. Kolehouse*
 EARTH TECH

Date 9-1-98

Surveyor's Michigan License No. 25854