

\$7.00
\$2.00

MAR 08 1999

SECTION

LAND CORNER RECORDATION CERTIFICATE
Filing Requirement of Act 74, Mich. P.A. 1970
KENT COUNTY REMONUMENTATION

STATE OF MICHIGAN
COUNTY OF KENT
RECEIVED FOR RECORD
30 OCT 23 AM 10:00
REG. OF DEEDS
Lucy S. Board

10889


Register of Deeds Stamp & File Number

For corners in

Kent (County)	Located in: Grattan Township	Corner Code #
1. Public Land Survey	T <u>8N</u> R <u>9W</u>	<u>I-11</u>
	T _____ R _____	_____
	T _____ R _____	_____
	T _____ R _____	_____
2. Property Controlling in Section	S _____ T _____ R _____	_____
	S _____ T _____ R _____	_____
3. Miscellaneous Property in Sec.	S _____ T _____ R _____	_____
	S _____ T _____ R _____	_____

4. Lot No. _____, Recorded Plat _____
5. Private Claims _____

I, Randy Kolehouse, in a field survey on February 6, 19 98, do hereby certify that under requirements of P.A. 74 Michigan P.A. of 1970, the corner points mentioned in lines 1 and 2 above were in conformance with regulations and rules therefore as required in the current manual of survey instructions of the United States Department of the Interior, Bureau of Land Management or by a decree of a Court of Law and/or that the corner points mentioned in lines 3, 4 and 5 above were in conformance with the rules of the Michigan Board of Land Surveyors or by a Decree of a Court of Law; established, re-established, monumented, re-monumented, recovered, found as expressed below:

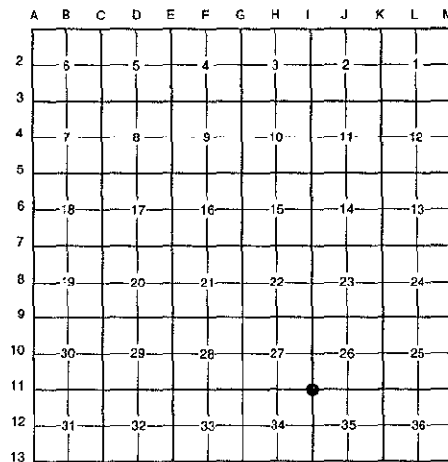

NOTE: Not more than 4 corners, all in the same town and range, may be recorded on this certificate.

A. Description of original monument and accessories and/or subsequent restoration:

I-11	1837	G.L.O. Notes	Cathcart	Set Post
	1944	Witness Map	K.C. Surveyor	1" Iron - 2 Large Stones
	1977	L.C.R.C. #966	Williams & Works	1" Iron in Monument Box
	1981	L.C.R.C. #1876	Jonker Land Survey	3/4" Iron in Mon. Box / Set K.C. Mon. in Mon. Box
	1991	L.C.R.C. #5881	William Byl	K.C. Monument in Monument Box

This corner was originally approved by the Kent County Remonumentation Peer Group and monumented by Rob Jonker on 6/12/81 and was recorded per L.C.R.C. #1876.

B. Description of corner evidence found and/or method applied in restoring or reestablishing corner:

I-11 Found a Standard Kent County Monument in a monument box at the C/L intersection of Lincoln Lake Road (bit.) running North and South and 5 Mile Road (bit.) running East and West per L.C.R.C.'s #1876 and #5881 as set by Rob Jonker in place of a 3/4" iron he found in a monument box over a 3/4" iron 18" below grade which checked L.C.R.C. #966.

L.C.R.C. #1876

L.C.R.C. #5881

Remon. tag on NE side p.pole N39°W 68.45'
Remon. tag on curb joint N55°E 52.35'
Remon. tag on curb joint S43°E 51.00'


Nail & KC Remon. tag NE side P. Pole N39°W 68.45'
Nail & KC Remon. tag on curb joint N55°E 52.56'
PK Nail & KC remon. tag on curb joint S43°E 50.90' (m. 50.88')

The selected location is accepted by me and is generally accepted by professional surveyors as the best available evidence of the position of the original corner.

C. Description of monument for corner and accessories established to perpetuate locating the position of the corner:

I-11 Standard Kent County Monument in a Monument Box
Nail & K.C. remon. tag on NE side P. pole N 39° W 68.45'
Nail & K.C. remon. tag on curb joint N 55° E 52.56'
Nail & K.C. remon. tag on curb joint S 43° E 50.88'
"X" cut on top of curb S 50° W 52.19'
On C/L "X" of bit. roads running N-S & E-W

P.A. 345 1990 KENT COUNTY
PEER APPROVED 6/25/98
CHAIRMAN Randy Kolehouse

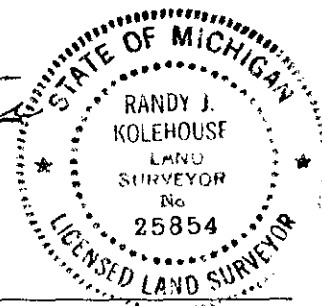

Signed by Randy J. Kolehouse

Date 9-1-98

Surveyor's Michigan License No. 25854