

MAR 08 1999

**LAND CORNER RECORDATION CERTIFICATE**  
**Filing Requirement of Act 74, Mich. P.A. 1970**  
**KENT COUNTY REMONUMENTATION**

For corners in SECTION

Kent (County)	Located in: Grattan Township	Corner Code #
1. Public Land Survey	T <u>8N</u> R <u>9W</u>	<u>J-2</u>
	T _____ R _____	_____
	T _____ R _____	_____
	T _____ R _____	_____
2. Property Controlling in Section	S _____ T _____ R _____	_____
	S _____ T _____ R _____	_____
3. Miscellaneous Property in Sec.	S _____ T _____ R _____	_____
	S _____ T _____ R _____	_____
4. Lot No. _____, Recorded Plat _____		
5. Private Claims _____		

STATE OF MICHIGAN  
 COUNTY OF KENT  
 RECEIVED FOR RECORD

98 DEC 14 AM 8:00


REG. OF DEEDS

*Randy Kolehose*

**11049**

Register of Deeds Stamp & File Number

I, Randy Kolehose, in a field survey on December 1 19 98, do hereby certify that under requirements of P.A. 74 Michigan P.A. of 1970, the corner points mentioned in lines 1 and 2 above were in conformance with regulations and rules therefore as required in the current manual of survey instructions of the United States Department of the interior, Bureau of Land Management or by a decree of a Court of Law and/or that the corner points mentioned in lines 3, 4 and 5 above were in conformance with the rules of the Michigan Board of Land Surveyors or by a Decree of a Court of Law; established, re-established, monumented, re-monumented, recovered, found as expressed below:

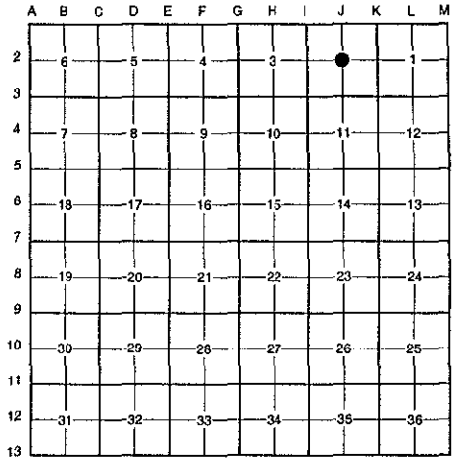

**NOTE: Not more than 4 corners, all in the same town and range, may be recorded on this certificate.**


A. Description of original monument and accessories and/or subsequent restoration:  
 J-2 This corner was not originally set by the G.L.O.  
 No information on record for this corner.

P.A. 345 1990 KENT COUNTY  
 PEER APPROVED 8/20/98  
 CHAIRMAN *[Signature]*

B. Description of corner evidence found and/or method applied in restoring or reestablishing corner:  
 J-2 Set a monument at the intersection of 1/4 lines. Monument is 4' ± North of the C/L of Hebron Road (bit.) running East and West and 150' ± West of a ditch running South.

The selected location is accepted by me and is generally accepted by professional surveyors as the best available evidence of the position of the original corner.

C. Description of monument for corner and accessories established to perpetuate locating the position of the corner:  
 J-2 Set a Standard Kent County Monument  
 Nail & K.C. remon. tag on NE side P. pole S 50° E 394.84'  
 Nail & K.C. remon. tag on E side P. pole S 10° W 223.92'  
 Nail & K.C. remon. tag on S side 10" Apple Tree N 73° W 210.99'  
 SE corner of most Easterly barn concrete foundation S 80° W 303.86'  
 C/L of bit. road running E-W, South 4'  
 Ditch running S, East 150'

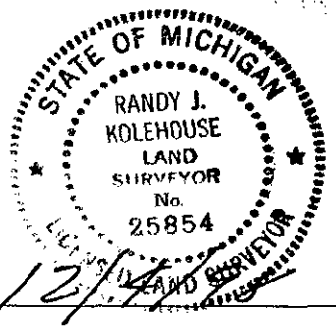

Signed by *[Signature]*  
 EARTH TECH

Date 12/1/98

Surveyor's Michigan License No. 25854