

7.00
12.00
MAR 08 1999

SECTION

LAND CORNER RECORDATION CERTIFICATE
Filing Requirement of Act 74, Mich. P.A. 1970
KENT COUNTY REMONUMENTATION

STATE OF MICHIGAN
COUNTY OF KENT
RECEIVED FOR RECORD
98 OCT 23 AM 10:00
REG. OF DEEDS
Lucy J. Janda

For corners in

Kent (County)	Located in: Grattan Township	Corner Code #
1. Public Land Survey	T <u>8N</u> R <u>9W</u>	<u>J-3</u>
	T _____ R _____	_____
	T _____ R _____	_____
	T _____ R _____	_____
2. Property Controlling in Section	S _____ T _____ R _____	_____
	S _____ T _____ R _____	_____
3. Miscellaneous Property in Sec.	S _____ T _____ R _____	_____
	S _____ T _____ R _____	_____

10890

Register of Deeds Stamp & File Number


4. Lot No. _____, Recorded Plat _____
5. Private Claims _____

I, Randy Kolehouse, in a field survey on March 19 19 98, do hereby certify that under requirements of P.A. 74 Michigan P.A. of 1970, the corner points mentioned in lines 1 and 2 above were in conformance with regulations and rules therefore as required in the current manual of survey instructions of the United States Department of the interior, Bureau of Land Management or by a decree of a Court of Law and/or that the corner points mentioned in lines 3, 4 and 5 above were in conformance with the rules of the Michigan Board of Land Surveyors or by a Decree of a Court of Law; established, re-established, monumented, re-monumented, recovered, found as expressed below:

NOTE: Not more than 4 corners, all in the same town and range, may be recorded on this certificate.

A. Description of original monument and accessories and/or subsequent restoration:

J-3	1837	G.L.O. Notes	Cathcart	Set Post
	1967	Notes	Williams & Works	N/A
	N/A	Notes	Glaza & Associates	3/4" Iron
	1985	L.C.R.C. #4299	R. Kolehouse	Fnd. 3/4" Iron / Set K.C. Monument
	1991	L.C.R.C. #5883	William Byl	K.C. Monument

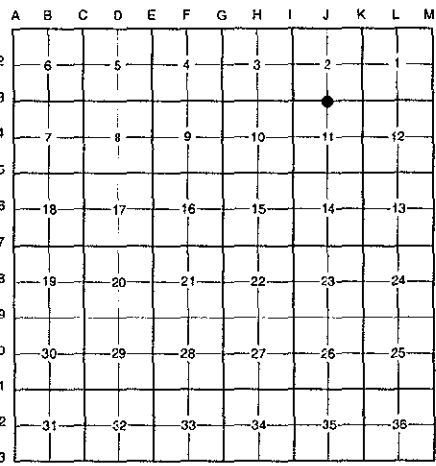

This corner was originally approved by the Kent County Remonumentation Peer Group and monumented by Randy Kolehouse on 5/10/91 and was recorded per L.C.R.C. #4299.

B. Description of corner evidence found and/or method applied in restoring or reestablishing corner:

J-3 Found a Standard Kent County Monument on line of downed fence lines running South, West and East and 5' ± South of a dirt path running East and West per L.C.R.C.'s #4299 and #5883 as set by Randy Kolehouse in place of a 3/4" iron he found at an old fence corner which checked the notes of Glaza & Associates and Williams & Works.

L.C.R.C. #4299

L.C.R.C. #5883

Nail & K.C. Remon. tag in NE side 14" Oak N 60° W 20.18'
 Nail & K.C. Remon. tag in E. side 10" Elm N 05° E 23.98'
 Nail & K.C. Remon. tag in SE side 16" Oak N 45° E 42.38'
 Nail & K.C. Remon. tag n SE side 10" Ash S 50° W 14.92'
 Steel fence post West 0.65'


Nail & KC Remon. tag NE side 16" Oak N60°W 20.11' (m. 20.12')
 Nail & KC Remon. tag E. side 10" Ironwood N05°E 24.02' (m. 24.01')
 Nail & KC Remon. tag SE side 20" Oak N45°E 42.25' (m. 42.30')
 Nail & KC Remon. tag SE side 10" Ash S50°W 14.61' (m. 14.64')
 Steel fence post S90°W 0.65' (m. 0.64')

The selected location is accepted by me and is generally accepted by professional surveyors as the best available evidence of the position of the original corner.

C. Description of monument for corner and accessories established to perpetuate locating the position of the corner:

J-3 Standard Kent County Monument
 Nail & K.C. remon. tag on NE side 16" Oak N 60° W 20.12'
 Nail & K.C. remon. tag on E side 10" Ironwood N 05° E 24.01'
 Nail & K.C. remon. tag on SE side 20" Oak N 45° E 42.30'
 Nail & K.C. remon. tag on SE side 10" Ash S 50° W 14.64'
 Steel fence post S 90° W 0.64'
 On downed fence lines running S-W-E
 Dirt path running E-W, North 5' ±

P.A. 345 1990 KENT COUNTY
 PEER APPROVED 6/25/98
 CHAIRMAN *Randy Kolehouse*

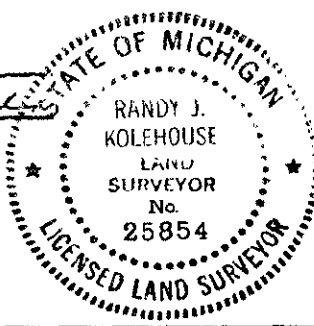

Signed by *Randy J. Kolehouse* Date 9-1-98

Surveyor's Michigan License No. 25854