

\$7.00
\$2.00
REMONUMENTATION
MAR 08 1999

LAND CORNER RECORDATION CERTIFICATE
Filing Requirement of Act 74, Mich. P.A. 1970
KENT COUNTY REMONUMENTATION

For corners in SECTION

Kent (County)	Located in:	Grattan Township	Corner Code #
1. Public Land Survey	T <u>8N</u>	R <u>9W</u>	<u>J-4</u>
	T _____	R _____	_____
	T _____	R _____	_____
	T _____	R _____	_____
2. Property Controlling in Section	S _____	T _____	R _____
	S _____	T _____	R _____
3. Miscellaneous Property in Sec.	S _____	T _____	R _____
	S _____	T _____	R _____


STATE OF MICHIGAN
COUNTY OF KENT
RECEIVED FOR RECORD
98 DEC 14 AM 8:00
REG. OF DEEDS
Luc Standa

10990

Register of Deeds Stamp & File Number

4. Lot No. _____, Recorded Plat _____
5. Private Claims _____

I, Randy Kolehouse, in a field survey on March 26 19 98, do hereby certify that under requirements of P.A. 74 Michigan P.A. of 1970, the corner points mentioned in lines 1 and 2 above were in conformance with regulations and rules therefore as required in the current manual of survey instructions of the United States Department of the interior, Bureau of Land Management or by a decree of a Court of Law and/or that the corner points mentioned in lines 3, 4 and 5 above were in conformance with the rules of the Michigan Board of Land Surveyors or by a Decree of a Court of Law; established, re-established, monumented, re-monumented, recovered, found as expressed below:

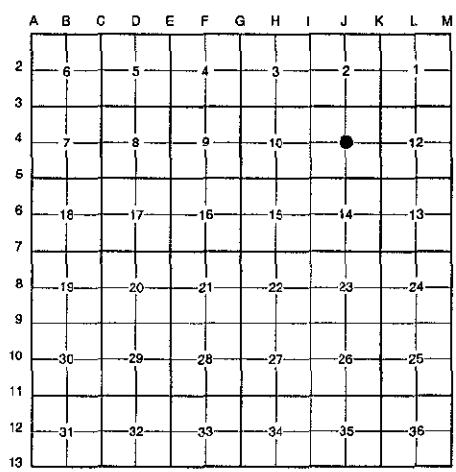

NOTE: Not more than 4 corners, all in the same town and range, may be recorded on this certificate.


- A. Description of original monument and accessories and/or subsequent restoration:
J-4 This corner was not originally set by the G.L.O.
- | | | | |
|------|---------------|-----------------------------|-------------------|
| 1935 | Witness Map | K.C. Surveyor | Concrete Monument |
| 1974 | L.C.R.C. #732 | Medema, Van Kooten & Assoc. | Concrete Monument |

P.A. 345 1990 KENT COUNTY
PEER APPROVED 11/12/98
CHAIRMAN *Frank Kube*

- B. Description of corner evidence found and/or method applied in restoring or reestablishing corner:
J-4 Found a 1/2" rebar 6' ± North of the C/L of Strotheide Road (gravel) running East and West on line of a tree row running North per L.C.R.C. # 732. Rebar is at the intersection of 1/4 lines. Accepted rebar as Center of Section.
- L.C.R.C. #732
Nail in 12" Walnut E-SE 141.52' (m. 151.65')
Nail in 16" Oak W-NW 72.40' (m. 72.18')
Nail in P. pole South 81.30' (m. 81.50')

The selected location is accepted by me and is generally accepted by professional surveyors as the best available evidence of the position of the original corner.

- C. Description of monument for corner and accessories established to perpetuate locating the position of the corner:
J-4 Replaced 1/2" Rebar with a Standard Kent County Monument
- Nail & K.C. remon. tag on SW side 14" Walnut S 58° E 151.65'
 - Nail & K.C. remon. tag on NE side 18" Oak N 70° W 72.18'
 - Nail & K.C. remon. tag on E side P. pole South 81.50'
 - Nail & K.C. remon. tag on NW side 10" Maple S 61° W 68.52'
 - Nail & K.C. remon. tag on E side 6" Maple N 11° E 16.64'
 - C/L of gravel road running E-W, South 6'
 - On tree row running N

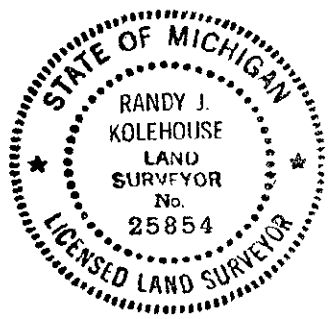

Signed by *Randy J. Kolehouse* Date 11/18/98
EARTH TECH
Surveyor's Michigan License No. 25854