

MAR 08 1999

LAND CORNER RECORDATION CERTIFICATE
Filing Requirement of Act 74, Mich. P.A. 1970
KENT COUNTY REMONUMENTATION


For corners in

Table with columns: Kent (County), Located in: Grattan Township, Corner Code #. Rows include Public Land Survey, Property Controlling in Section, Miscellaneous Property in Sec.

STATE OF MICHIGAN
COUNTY OF KENT
RECEIVED FOR RECORD
98 OCT 23 AM 10:00
10891
REG. OF DEEDS

Register of Deeds Stamp & File Number

- 4. Lot No.
5. Private Claims

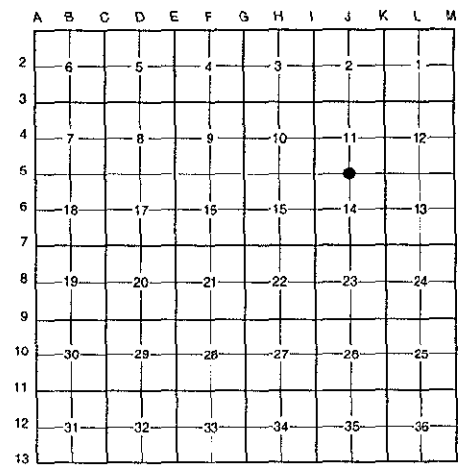

I, Randy Kolehouse, in a field survey on March 19 19 98, do hereby certify that under requirements of P.A. 74 Michigan P.A. of 1970, the corner points mentioned in lines 1 and 2 above were in conformance with regulations and rules therefore as required in the current manual of survey instructions of the United States Department of the Interior, Bureau of Land Management or by a decree of a Court of Law and/or that the corner points mentioned in lines 3, 4 and 5 above were in conformance with the rules of the Michigan Board of Land Surveyors or by a Decree of a Court of Law; established, re-established, monumented, re-monumented, recovered, found as expressed below:

NOTE: Not more than 4 corners, all in the same town and range, may be recorded on this certificate.

A. Description of original monument and accessories and/or subsequent restoration:

Table with columns: J-5, 1837, G.L.O. Notes, Cathcart, Set Post. Rows include 1837, 1974, 1981, 1991 with descriptions of monuments and notes.

P.A. 345 1990 KENT COUNTY
PEER APPROVED 6/25/99
CHAIRMAN [Signature]

This corner was originally approved by the Kent County Remonumentation Peer Group and monumented Rob Jonker on 6/16/81 and was recorded per L.C.R.C. #2019.

B. Description of corner evidence found and/or method applied in restoring or reestablishing corner:

J-5 Found a Standard Kent County Monument on line of a downed fence line running East and West, on top of hill on South side of an abandoned gravel pit, per L.C.R.C.'s #2019 and #5884 as set by Rob Jonker in place of a "T" iron he found which checked L.C.R.C. #733.

L.C.R.C. #2019

L.C.R.C. #5884


- Remon. tag on S side 8" tw. Hickory S77°E 42.50'
Remon. tag on W side 6" cherry S19°W 24.13'
Remon. tag on SE side 8" Oak S79°W 28.63'
Remon. tag on NW side 4" Hickory S46°W 11.57'

- Nail & KC Remon. tag S. side 8" Tw. Hickory S77°E 42.50' (m. 42.54')
Nail & KC Remon. tag W. side Tri. 6" Cherry S19°W 24.13' (m. 24.15')
Nail & KC Remon. tag SE side 10" Oak S79°W 28.64' (m. 28.67')
Nail & KC Remon. tag NW side 6" Hickory S46°W 11.55' (m. 11.54')
Nail & KC Remon. tag NW side 10" Oak S25°W 32.95' (m. 32.98')

The selected location is accepted by me and is generally accepted by professional surveyors as the best available evidence of the position of the original corner.

C. Description of monument for corner and accessories established to perpetuate locating the position of the corner:

- J-5 Standard Kent County Monument
Nail & K.C. remon. tag on S side 8" twin Hickory S77°E 42.54'
Nail & K.C. remon. tag on W side 6" triple Cherry S 19° W 24.15'
Nail & K.C. remon. tag on SE side 10" Oak S 79° W 28.67'
Nail & K.C. remon. tag on NW side 6" Hickory S 46° W 11.54'
Nail & K.C. remon. tag on NW side 10" Oak S 25° W 32.98'
Nail & K.C. remon. tag on W side 4" Hickory S 15° W 29.65'
On downed fence line running E-W
On top of hill on S side of gravel pit

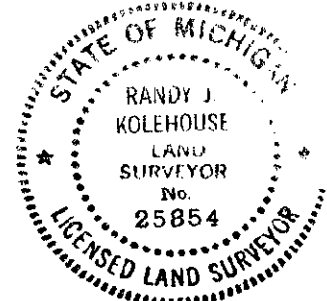

Signed by [Signature] Date 9-1-98

Surveyor's Michigan License No. 25854