

**\$7.00**  
**\$2.00**  
SURVEY &  
REMONUMENTATION

MAR 08 1999

**LAND CORNER RECORDATION CERTIFICATE**  
**Filing Requirement of Act 74, Mich. P.A. 1970**  
**KENT COUNTY REMONUMENTATION**

For corners in Kent (County) SECTION Located in: Grattan Township Corner Code #

1. Public Land Survey T 8N R 9W J-7  
T \_\_\_\_\_ R \_\_\_\_\_  
T \_\_\_\_\_ R \_\_\_\_\_  
T \_\_\_\_\_ R \_\_\_\_\_

2. Property Controlling in Section S \_\_\_\_\_ T \_\_\_\_\_ R \_\_\_\_\_  
S \_\_\_\_\_ T \_\_\_\_\_ R \_\_\_\_\_

3. Miscellaneous Property in Sec. S \_\_\_\_\_ T \_\_\_\_\_ R \_\_\_\_\_  
S \_\_\_\_\_ T \_\_\_\_\_ R \_\_\_\_\_

4. Lot No. \_\_\_\_\_, Recorded Plat \_\_\_\_\_

5. Private Claims \_\_\_\_\_

STATE OF MICHIGAN  
COUNTY OF KENT  
RECEIVED FOR RECORD  
38 DEC 14 AM 8:00  
REG. OF DEEDS  
*Luigi Standa*


**10991**  
Register of Deeds Stamp & File Number

I, Randy Kolehouse, in a field survey on February 26 19 98, do hereby certify that under requirements of P.A. 74 Michigan P.A. of 1970, the corner points mentioned in lines 1 and 2 above were in conformance with regulations and rules therefore as required in the current manual of survey instructions of the United States Department of the interior, Bureau of Land Management or by a decree of a Court of Law and/or that the corner points mentioned in lines 3, 4 and 5 above were in conformance with the rules of the Michigan Board of Land Surveyors or by a Decree of a Court of Law; established, re-established, monumented, re-monumented, recovered, found as expressed below:

**NOTE: Not more than 4 corners, all in the same town and range, may be recorded on this certificate.**

**A. Description of original monument and accessories and/or subsequent restoration:**

J-7	1837	G.L.O. Notes	Cathcart	Set Post
	1939	Witness Map	K.C. Surveyor	1" iron
	1973	L.C.R.C. #504	Williams & Works	1" iron
	1981	L.C.R.C. #2020	Jonker Land Survey	Fnd. 1" Iron / Set K.C. Monument
	1991	L.C.R.C. #5885	William Byl	K.C. Monument

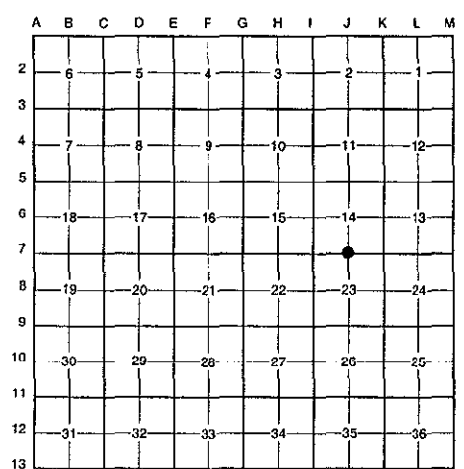

P.A. 345 1990 KENT COUNTY  
PEER APPROVED 9/24/98  
CHAIRMAN Hans Stube

This corner was originally approved by the Kent County Remonumentation Peer Group and monumented by Rob Jonker on 6/16/81 and was recorded per L.C.R.C. #2020.

**B. Description of corner evidence found and/or method applied in restoring or reestablishing corner:**

J-7 Found a Standard Kent County Monument 5' South of the C/L of 7 Mile Road (gravel) running East and West and 40' West of a fence line running North per L.C.R.C.'s #2020 and #5885 as set by Rob Jonker in place of a 1" iron he found which checked L.C.R.C. #504 and the K.C. Surveyor's records.

**L.C.R.C. #2020**

**L.C.R.C. #5885**


- Remon. tag on SW side 36" Maple N27°W 37.36'
- Remon. tag on S side 36" Maple N48°E 46.33'
- Remon. tag on S side P.pole S68°E 81.69'
- Remon. tag on S side 16" Basswood N69°E 78.83'
- NW cor. base of conc. post S32°E 57.65'

- Nail & KC Remon. tag SW side 36" Maple N27°W 37.30'
- Nail & KC Remon. tag S. side 40" maple N48°E 46.69' (m. 46.70')
- Nail & KC Remon. tag S. side P. Pole S68°E 81.69' (m. 81.70')
- Nail & KC Remon. tag S. side 20" Basswood N69°E 78.88' (m. 78.87')
- NW cor. base of conc. post S32°E 57.69' (m. 57.65')

The selected location is accepted by me and is generally accepted by professional surveyors as the best available evidence of the position of the original corner.

**C. Description of monument for corner and accessories established to perpetuate locating the position of the corner:**

- J-7 Standard Kent County Monument
- Nail & K.C. remon. tag on SW side 36" Maple N 27° W 37.30'
  - Nail & K.C. remon. tag on S side 40" Maple N 48° E 46.70'
  - Nail & K.C. remon. tag on S side P. pole S 68° E 81.70'
  - Nail & K.C. remon. tag on S side 20" Basswood N 69° E 78.87'
  - NW cor. base to conc. post S 32° E 57.65'
  - C/L of gravel road running E-W, North 5'
  - Fence line running N, East 40'

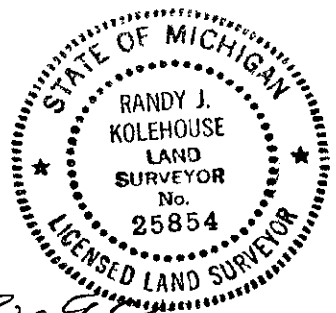

Signed by Randy J. Kolehouse Date 9-30-98  
EARTH TECH

Surveyor's Michigan License No. 25854