

SURVEY & REMONUMENTATION

\$7.00
\$2.00

MAR 08 1999

LAND CORNER RECORDATION CERTIFICATE
Filing Requirement of Act 74, Mich. P.A. 1970
KENT COUNTY REMONUMENTATION

STATE OF MICHIGAN
COUNTY OF KENT
RECEIVED FOR RECORD
38 DEC 14 AM 8:00
REG. OF DEEDS
Lucy Bond

For corners in SECTION

Kent (County)	Located in:	Grattan Township	Corner Code #
1. Public Land Survey	T <u>8N</u> R <u>9W</u>		<u>J-9</u>
	T _____ R _____		_____
	T _____ R _____		_____
	T _____ R _____		_____
2. Property Controlling in Section	S _____ T _____ R _____		_____
	S _____ T _____ R _____		_____
3. Miscellaneous Property in Sec.	S _____ T _____ R _____		_____
	S _____ T _____ R _____		_____

10992

Register of Deeds Stamp & File Number

4. Lot No. _____, Recorded Plat _____
5. Private Claims _____

I, Randy Kolehouse, in a field survey on February 26 19 98, do hereby certify that under requirements of P.A. 74 Michigan P.A. of 1970, the corner points mentioned in lines 1 and 2 above were in conformance with regulations and rules therefore as required in the current manual of survey instructions of the United States Department of the interior, Bureau of Land Management or by a decree of a Court of Law and/or that the corner points mentioned in lines 3, 4 and 5 above were in conformance with the rules of the Michigan Board of Land Surveyors or by a Decree of a Court of Law; established, re-established, monumented, re-monumented, recovered, found as expressed below:

	A	B	C	D	E	F	G	H	I	J	K	L	M
2	6	5	4	3	2	1							
3													
4	7	8	9	10	11	12							
5													
6	18	17	16	15	14	13							
7													
8	19	20	21	22	23	24							
9													
10	30	29	28	27	26	25							
11													
12	31	32	33	34	35	36							

NOTE: Not more than 4 corners, all in the same town and range, may be recorded on this certificate.

A. Description of original monument and accessories and/or subsequent restoration:

J-9	1837	G.L.O. Notes	Cathcart	Set Post
	1956-66	Witness Map	K.C. Surveyor	3/4" Iron
	1983	L.C.R.C. #3648	John Bueche	Fnd. 3/4" Iron in Mon Box / Set K.C. Mon. in Mon. Box
	1991	L.C.R.C. #5886	William Byl	K.C. Monument in a Monument Box

This corner was originally approved by the Kent County Remonumentation Peer Group and monumented by John Bueche on 11/21/83 and was recorded per L.C.R.C. #3648.

B. Description of corner evidence found and/or method applied in restoring or reestablishing corner:

J-9 Found a Standard Kent County Monument in a monument box 1' North of the C/L of 6 Mile Road (bit.) running East and West, on line of a tree row running North, per L.C.R.C.'s #3648 and #5886 as set by John Bueche in place of a 3/4" iron he found in a monument box which checked the K.C. Surveyor's records.

L.C.R.C. #3648

L.C.R.C. #5886

K.C. Remon. tag & nail in W side 8" Thornapple N 25° W 42.10'	KC Remon. tag & nail W. side 8" Thornapple N25°W 42.10' (m. 42.09')
K.C. Remon. tag & nail in S side (5' up) Elm S 55° W 73.38'	KC Remon. tag & nail (6' high) S. side 12" Elm S55°W 73.32' (m. 73.28')
K.C. Remon. tag & nail in E side group 10" Willows (5' up) S 0° W 88.84'	KC Remon. tag & nail E. side group 16" Willows (5' up) S00°W 88.80' (m. 88.77')
	KC Remon. tag & nail E. side 27" Oak N00°E 73.44' (m. 73.40')


The selected location is accepted by me and is generally accepted by professional surveyors as the best available evidence of the position of the original corner.

C. Description of monument for corner and accessories established to perpetuate locating the position of the corner:

J-9 Standard Kent County Monument in a Monument Box

- Nail & K.C. remon. tag on W side 8" Thornapple N 25° W 42.09'
- Nail & K.C. remon. tag on S side 12" Elm S 55° W 73.28'
- Nail & K.C. remon. tag on E side 16" Hickory S 00° W 88.77'
- Nail & K.C. remon. tag on E side 28" Oak N 00° E 73.40'
- C/L of bit. road running E-W, South 1'
- On tree row running N

P.A. 345 1990 KENT COUNTY
PEER APPROVED *9/24/98*
CHAIRMAN *Randy Kolehouse*

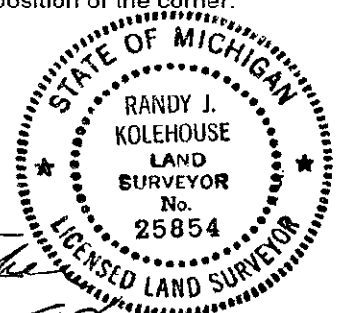

Signed by *Randy J. Kolehouse* Date *9-30-98*
EARTH TECH

Surveyor's Michigan License No. 25854