

SURVEY & REMONUMENTATION

\$7.00
\$2.00

MAR 08 1999

LAND CORNER RECORDATION CERTIFICATE

Filing Requirement of Act 74, Mich. P.A. 1970

KENT COUNTY REMONUMENTATION

SECTION

For corners in

Kent (County)	Located in:	Grattan Township	Corner Code #
1. Public Land Survey	T <u>8N</u>	R <u>9W</u>	<u>J-10</u>
	T _____	R _____	_____
	T _____	R _____	_____
	T _____	R _____	_____
2. Property Controlling in Section	S _____	T _____	R _____
	S _____	T _____	R _____
3. Miscellaneous Property in Sec.	S _____	T _____	R _____
	S _____	T _____	R _____


STATE OF MICHIGAN
COUNTY OF KENT
RECEIVED FOR RECORD
98 DEC 14 AM 8:00
REG. OF DEEDS
Lucy St. Grand

11052

Register of Deeds Stamp & File Number

4. Lot No. _____, Recorded Plat _____
5. Private Claims _____

I, Randy Kolehouse, in a field survey on March 26 19 98, do hereby certify that under requirements of P.A. 74 Michigan P.A. of 1970, the corner points mentioned in lines 1 and 2 above were in conformance with regulations and rules therefore as required in the current manual of survey instructions of the United States Department of the Interior, Bureau of Land Management or by a decree of a Court of Law and/or that the corner points mentioned in lines 3, 4 and 5 above were in conformance with the rules of the Michigan Board of Land Surveyors or by a Decree of a Court of Law; established, re-established, monumented, re-monumented, recovered, found as expressed below:

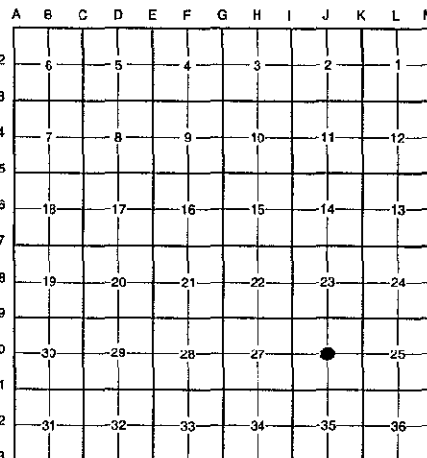

NOTE: Not more than 4 corners, all in the same town and range, may be recorded on this certificate.

A. Description of original monument and accessories and/or subsequent restoration:

J-10 This corner was not originally set by the G.L.O.

1944 Witness Map K.C. Surveyor 3" Iron
1992 L.C.R.C. #6559 John Bueche Set K.C. Monument at Int. of 1/4 Lines

B. Description of corner evidence found and/or method applied in restoring or reestablishing corner:

J-10 Found a Kent County Monument on an old fence line running West, on the West edge of woods running South, per L.C.R.C. # 6559 as set by John Bueche at the intersection of 1/4 lines. Accepted monument as Center of Section.

L.C.R.C. #6559

- Nail & K.C. Remon. Tag in N side 18" Hickory S 80° W 19.82' (m. 19.85')
- Nail & K.C. Remon. Tag in NE side 12" Oak S 35° E 6.30' (m. 6.29')
- Nail & K.C. Remon. Tag in NW side 6" Maple N 85° E 31.03' (m. 31.02')
- Nail & K.C. Remon. Tag in E side 3-10" Maples N 10° E 15.50'
- Nail & K.C. Remon. Tag in W side 18" Hickory S 34.55' (m. 34.60')
- 12" dia. Wood fence post S 80° W 4.5'+/-
- On old fence W
- On W edge of woods South

P.A. 345 1990 KENT COUNTY
PEER APPROVED 12/3/98
CHAIRMAN Harry Hubers

The selected location is accepted by me and is generally accepted by professional surveyors as the best available evidence of the position of the original corner.

C. Description of monument for corner and accessories established to perpetuate locating the position of the corner:

J-10 Replaced Monument with a Standard Kent County Monument

- Nail & K.C. remon. tag on N side 18" Hickory S 80° W 19.85'
- Nail & K.C. remon. tag on NE side 12" Oak S 35° E 6.29'
- Nail & K.C. remon. tag on NW side 6" Maple N 85° E 31.02'
- Nail & K.C. remon. tag on E side 3 - 10" Maples N 10° E 15.50'
- Nail & K.C. remon. tag on W side 18" Hickory South 34.60'
- On old fence line running W
- On W edge of woods running South



Signed by Randy J. Kolehouse Date 12/4/98

EARTH TECH

Surveyor's Michigan License No. 25854