

\$7.00  
\$2.00

MAR 08 1999

LAND CORNER RECORDATION CERTIFICATE  
Filing Requirement of Act 74, Mich. P.A. 1970  
KENT COUNTY REMONUMENTATION

SECTION

For corners in

Kent (County)	Located in: Grattan Township	Corner Code #
1. Public Land Survey	T <u>8N</u> R <u>9W</u>	<u>J-11</u>
	T _____ R _____	_____
	T _____ R _____	_____
	T _____ R _____	_____
2. Property Controlling in Section	S _____ T _____ R _____	_____
	S _____ T _____ R _____	_____
3. Miscellaneous Property in Sec.	S _____ T _____ R _____	_____
	S _____ T _____ R _____	_____

STATE OF MICHIGAN  
COUNTY OF KENT  
RECEIVED FOR RECORD  
38 OCT 23 AM 10:00  
REG. OF DEEDS  
*Lucy Bond*

10892

Register of Deeds Stamp & File Number

- 4. Lot No. \_\_\_\_\_, Recorded Plat \_\_\_\_\_
- 5. Private Claims \_\_\_\_\_


I, Randy Kolehouse, in a field survey on February 27 19 98, do hereby certify that under requirements of P.A. 74 Michigan P.A. of 1970, the corner points mentioned in lines 1 and 2 above were in conformance with regulations and rules therefore as required in the current manual of survey instructions of the United States Department of the interior, Bureau of Land Management or by a decree of a Court of Law and/or that the corner points mentioned in lines 3, 4 and 5 above were in conformance with the rules of the Michigan Board of Land Surveyors or by a Decree of a Court of Law; established, re-established, monumented, re-monumented, recovered, found as expressed below:

NOTE: Not more than 4 corners, all in the same town and range, may be recorded on this certificate.

A. Description of original monument and accessories and/or subsequent restoration:

J-11	1837	G.L.O. Notes	Cathcart	Set Post
	1944	Witness Map	K.C. Surveyor	3" Iron
	1984	L.C.R.C. #3758	R. Kolehouse	Set K.C. Monument
	1991	L.C.R.C. #5887	William Byl	K.C. Monument

P.A.: 345 1990 KENT COUNTY  
PEER APPROVED 6/11/98  
CHAIRMAN *[Signature]*

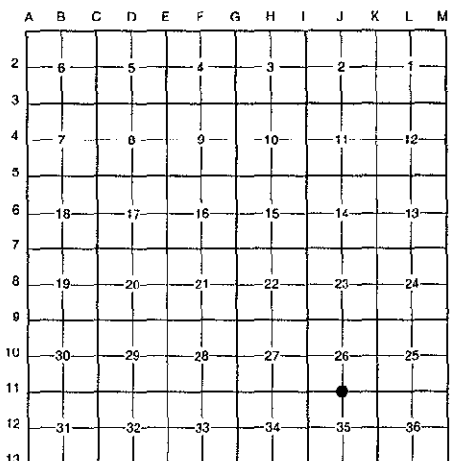

This corner was originally approved by the Kent County Remonumentation Peer Group and monumented by Randy Kolehouse in February 1984 and was recorded per L.C.R.C. #3758.

B. Description of corner evidence found and/or method applied in restoring or reestablishing corner:

J-11 Found a Standard Kent County Monument 2' North of the C/L of 5 Mile Road (gravel) running East and West per L.C.R.C.'s #3758 and #5887 as set by Randy Kolehouse using Caukins' 1847 notes & occupation (iron per K.C. witness map was 26.15' West).

L.C.R.C. #3758

- Nail & K.C. Remon. tag in E. side 12" Elm S 20° E 37.37'
- Nail & K.C. Remon. tag in W. side 12" Elm South 42.16'
- Nail & K.C. Remon. tag in SW side 10" Elm N 45° W 47.73'

L.C.R.C. #5887

- Nail & KC Remon. tag E. side 12" Elm (dead) S20°E 37.28' (m. 37.30')
- Nail & KC Remon. tag W. side 12" Elm (dead) S00°W 42.21'
- Nail & KC Remon. tag SW side 10" Elm Stump N45°W 47.73' (m. 47.61')
- Round Iron West 26.25'
- Nail & KC Remon. tag W. side 36" Willow S35°E 50.29' (50.70')
- Nail & KC Remon. tag S. side 24" Willow N70°E 50.38' (m. 50.82')

The selected location is accepted by me and is generally accepted by professional surveyors as the best available evidence of the position of the original corner.

C. Description of monument for corner and accessories established to perpetuate locating the position of the corner:

- J-11 Standard Kent County Monument
- Nail & K.C. remon. tag on E side 12" Elm (dead) S 20° E 37.30'
  - Nail & K.C. remon. tag on W side 12" Elm (dead) S 00° E 42.21'
  - Nail & K.C. remon. tag on SW side 10" stump N 45° W 47.61'
  - Nail & K.C. remon. tag on W side 36" Willow S 35° E 50.70'
  - 3/4" Round Iron Bar West 26.25'
  - Nail & K.C. remon. tag on S side 24" Willow N 70° E 50.82'
  - C/L of gravel road running E-W, South 2'



Signed by *Randy J. Kolehouse* Date 9-1-98  
EARTH TECH

Surveyor's Michigan License No. 25854