

\$7.00
\$2.00

SURVEY &
REMONUMENTATION

MAR 08 1999

LAND CORNER RECORDATION CERTIFICATE
Filing Requirement of Act 74, Mich. P.A. 1970
KENT COUNTY REMONUMENTATION

For corners in

Kent (County)	SECTION	Located in: Grattan Township	Corner Code #
1. Public Land Survey	T 8N R 9W	J-13	
	T R		
	T R		
	T R		
2. Property Controlling in Section	S T R		
	S T R		
3. Miscellaneous Property in Sec.	S T R		
	S T R		


REG. OF DEEDS
38 DEC 14 AM 8:00
STATE OF MICHIGAN
COUNTY OF KENT
RECEIVED FOR RECORDING

10993

Register of Deeds Stamp & File Number

4. Lot No. _____, Recorded Plat _____
5. Private Claims _____

I, Randy Kolehouse, in a field survey on January 8 19 98, do hereby certify that under requirements of P.A. 74 Michigan P.A. of 1970, the corner points mentioned in lines 1 and 2 above were in conformance with regulations and rules therefore as required in the current manual of survey instructions of the United States Department of the interior, Bureau of Land Management or by a decree of a Court of Law and/or that the corner points mentioned in lines 3, 4 and 5 above were in conformance with the rules of the Michigan Board of Land Surveyors or by a Decree of a Court of Law; established, re-established, monumented, re-monumented, recovered, found as expressed below:

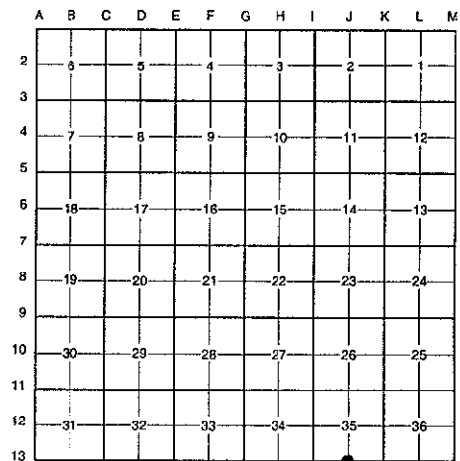

NOTE: Not more than 4 corners, all in the same town and range, may be recorded on this certificate.

A. Description of original monument and accessories and/or subsequent restoration:

J-13	1837	G.L.O. Notes	N. Brookfield	Maple
	1983	L.C.R.C. #3692	Glaza & Associates:	Set 1/2" Re-rod
	1985	L.C.R.C. #4363	R. Kolehouse	Fnd. 1/2" Rebar / Set K.C. Monument
	1991	L.C.R.C. #5888	William Byl	K.C. Monument

P.A. 345 1990 KENT COUNTY
PEER APPROVED 9/22/98
CHAIRMAN *[Signature]*

Note: This corner is not common with J-1, T7N, R9W.

This corner was originally approved by the Kent County Remonumentation Peer Group and monumented by R. Kolehouse on 11/23/98 and was recorded per L.C.R.C. #4363.

B. Description of corner evidence found and/or method applied in restoring or reestablishing corner:

J-13 Found a Standard Kent County Monument on the C/L of 4 Mile Road (gravel) running East and West and 600' ± East of railroad tracks running North and South per L.C.R.C.'s #4363 and #5888 as set by Randy Kolehouse in place of a 1/2" rebar he found which checked L.C.R.C. #3692.

L.C.R.C. #4363	L.C.R.C. #5888
Nail & K.C. Remon. tag in N. side 14" Ash S 70° W 56.95'	Nail & KC Remon. tag N. side 16" Ash S70°W 56.95' (m. 56.90')
Nail & K.C. Remon. tag in N. side 14" Maple S 45° W 27.58'	Nail & KC Remon. tag N. side 18" Maple S45°W 27.58' (m. 27.54')
Nail & K.C. Remon. tag in W. side tw 6" Ash S 30° E 26.32'	Nail & KC Remon. tag W. side Tw. 6" Ash S30°E 26.32' (m. 26.33')
Nail In W. side P.Pole N 20° E 28.1'	PK Nail in W. side P. Pole N20°E 27.83'
	KC Monument at N 1/4 cor. Sec. 2, T7N, R9W N90°E 18.85' (m. 18.87')

The selected location is accepted by me and is generally accepted by professional surveyors as the best available evidence of the position of the original corner.

C. Description of monument for corner and accessories established to perpetuate locating the position of the corner:

J-13 Standard Kent County Monument
Nail & K.C. remon. tag on N side 16" Ash S 70° W 56.90'
Nail & K.C. remon. tag on N side 18" Maple S 45° W 27.54'
Nail & K.C. remon. tag on W side twin 6" Ash S 30° E 26.33'
Nail & K.C. remon. tag on W side P. pole N 20° E 27.83'
Railroad tracks running N-S, West 600' ±
On C/L of gravel road running E-W
K.C. Mon., J-1, T7N, R9W, N 90° E 18.87'



Signed by Randy J. Kolehouse Date 9-30-98
EARTH TECH
Surveyor's Michigan License No. 25854