

\$7.00  
\$2.00

MAR 08 1999

SECTION

LAND CORNER RECORDATION CERTIFICATE  
Filing Requirement of Act 74, Mich. P.A. 1970  
KENT COUNTY REMONUMENTATION

STATE OF MICHIGAN  
COUNTY OF KENT  
RECEIVED FOR RECORD  
38 DEC 14 AM 8:00  
REG. OF DEEDS  
*Luigi Bond*

10995

Register of Deeds Stamp & File Number

For corners in

Kent  
(County)

Located in: Grattan  
Township

Corner Code #

- 1. Public Land Survey T 8N R 9W K-2  
T \_\_\_\_\_ R \_\_\_\_\_  
T \_\_\_\_\_ R \_\_\_\_\_  
T \_\_\_\_\_ R \_\_\_\_\_
- 2. Property Controlling in Section S \_\_\_\_\_ T \_\_\_\_\_ R \_\_\_\_\_  
S \_\_\_\_\_ T \_\_\_\_\_ R \_\_\_\_\_
- 3. Miscellaneous Property in Sec. S \_\_\_\_\_ T \_\_\_\_\_ R \_\_\_\_\_  
S \_\_\_\_\_ T \_\_\_\_\_ R \_\_\_\_\_


- 4. Lot No. \_\_\_\_\_, Recorded Plat \_\_\_\_\_
- 5. Private Claims \_\_\_\_\_

I, Randy Kolehouse, in a field survey on January 29 19 98, do hereby certify that under requirements of P.A. 74 Michigan P.A. of 1970, the corner points mentioned in lines 1 and 2 above were in conformance with regulations and rules therefore as required in the current manual of survey instructions of the United States Department of the interior, Bureau of Land Management or by a decree of a Court of Law and/or that the corner points mentioned in lines 3, 4 and 5 above were in conformance with the rules of the Michigan Board of Land Surveyors or by a Decree of a Court of Law; established, re-established, monumented, re-monumented, recovered, found as expressed below:

NOTE: Not more than 4 corners, all in the same town and range, may be recorded on this certificate.

A. Description of original monument and accessories and/or subsequent restoration:

K-2	1837	G.L.O. Notes	Cathcart	Set Post
	N/A	Witness Map	K.C. Surveyor	Concrete Monument
	1979	L.C.R.C. #1282	C. Hay	Iron & Cap
	1981	L.C.R.C. #1873	Jonker Land Survey	Fnd. 1/2" Rerod & Cap / Set K.C. Monument
	1991	L.C.R.C. #5889	William Byl	K.C. Monument

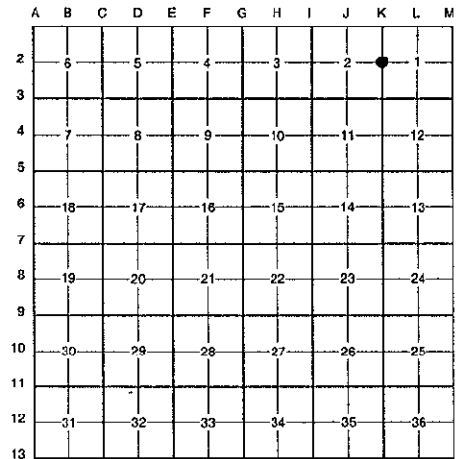

P.A. 345 1990 KENT COUNTY  
PEER APPROVED 9/24/98  
CHAIRMAN Randy Kolehouse

This corner was originally approved by the Kent County Remonumentation Peer Group and monumented by Rob Jonker on 6/19/81 and was recorded per L.C.R.C. #1873.

B. Description of corner evidence found and/or method applied in restoring or reestablishing corner:

K-2 Found a Standard Kent County Monument on the C/L intersection of Ashley Avenue (bit.) running North and South and Heffron Road (bit.) running East and West per L.C.R.C.'s #1873 and #5889 as set by Rob Jonker in place of a 1/2" rerod & cap he found at grade over a plat monument 16" below grade which checked L.C.R.C. #1282 and the K.C. Surveyor's records.

L.C.R.C. #1873

L.C.R.C. #5889

Remon. tag on N side p. pole N70°W 155.40'  
Remon. tag on SW side 34" Maple S39°E 57.25'


Nail & KC Remon. tag N. side P. Pole N70°W 155.40' (m. 155.60')  
Nail & KC Remon. tag SW side 36" Maple S39°E 57.25' (m. 57.20')  
NW cor. hse. Fdn. S35°E 109.47' (m. 109.41')  
Nail & KC Remon. tag SE side 6" Apple N35°E 77.48'  
Nail & KC Remon. tag NE side 12" Apple N40°W 73.87' (m. 73.94')

The selected location is accepted by me and is generally accepted by professional surveyors as the best available evidence of the position of the original corner.

C. Description of monument for corner and accessories established to perpetuate locating the position of the corner:

K-2 Standard Kent County Monument

- Nail & K.C. remon. tag on N side P. pole N 70° W 155.60'
- Nail & K.C. remon. tag SW side 36" Maple S39°E 57.20'
- Nail & K.C. remon. tag on SE side 6" Apple N 35° E 77.48'
- Nail & K.C. remon. tag on NE side 12" Apple N 40° W 73.94'
- Nail & K.C. remon. tag on curb joint S 48° W 36.15'
- NW cor. conc. hse. fdn. S 35° E 109.41'
- On C/L "X" of bit. roads running N-S & E-W

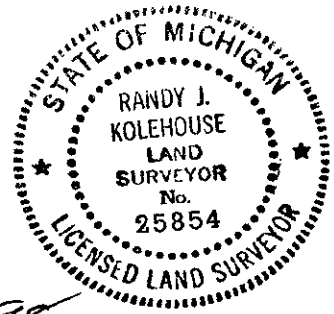

Signed by Randy J. Kolehouse Date 9-30-98  
EARTH TECH

Surveyor's Michigan License No. 25854