

\$7.00  
\$2.00

MAR 08 1999

LAND CORNER RECORDATION CERTIFICATE

Filing Requirement of Act 74, Mich. P.A. 1970

KENT COUNTY REMONUMENTATION

For corners in SECTION


Kent (County)	Located in:	Grattan Township	Corner Code #
1. Public Land Survey	T <u>8N</u>	R <u>9W</u>	<u>K-3</u>
	T _____	R _____	_____
	T _____	R _____	_____
	T _____	R _____	_____
2. Property Controlling in Section	S _____	T _____	R _____
	S _____	T _____	R _____
3. Miscellaneous Property in Sec.	S _____	T _____	R _____
	S _____	T _____	R _____

STATE OF MICHIGAN  
COUNTY OF KENT  
RECEIVED FOR RECORDS  
98 OCT 23 AM 10:00  
10893  
REG. OF DEEDS  
*Lucy Standa*

Register of Deeds Stamp & File Number

4. Lot No. \_\_\_\_\_, Recorded Plat \_\_\_\_\_  
5. Private Claims \_\_\_\_\_

I, Randy Kolehouse, in a field survey on February 26 19 98, do hereby certify that under requirements of P.A. 74 Michigan P.A. of 1970, the corner points mentioned in lines 1 and 2 above were in conformance with regulations and rules therefore as required in the current manual of survey instructions of the United States Department of the interior, Bureau of Land Management or by a decree of a Court of Law and/or that the corner points mentioned in lines 3, 4 and 5 above were in conformance with the rules of the Michigan Board of Land Surveyors or by a Decree of a Court of Law; established, re-established, monumented, re-monumented, recovered, found as expressed below:

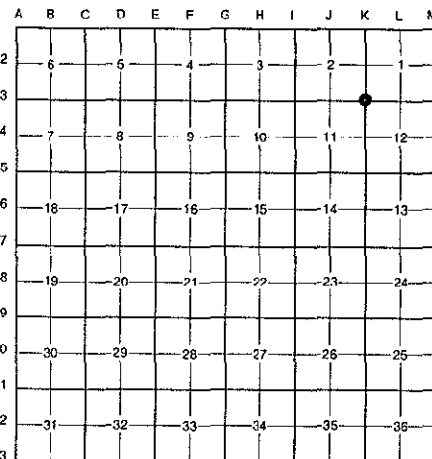

**NOTE: Not more than 4 corners, all in the same town and range, may be recorded on this certificate.**

A. Description of original monument and accessories and/or subsequent restoration:

K-3	1837	G.L.O. Notes	Cathcart	Set Post
	1935	Witness Map	K.C. Surveyor	1' Iron Over Stone
	1983	L.C.R.C. #3304	Glaza & Associates	Iron
	1985	L.C.R.C. #4300	R. Kolehouse	Fnd. 3/4" Iron / Set K.C. Monument Over Stone
	1991	L.C.R.C. #5890	William Byl	K.C. Monument

This corner was originally approved by the Kent County Remonumentation Peer Group and monumented by Randy Kolehouse on 8/10/85 and was recorded per L.C.R.C. #4300.

B. Description of corner evidence found and/or method applied in restoring or reestablishing corner:

K-3 Found a Standard Kent County Monument (broken) on the C/L of Ashley Avenue (gravel) running North and South, on line of a field division line running East, per L.C.R.C.'s #4300 and #5890 as set by Randy Kolehouse in place of a 3/4" iron he found over a stone 24" below grade which checked L.C.R.C. #3304 and the K.C. Surveyor's records.

L.C.R.C. #4390

Nail & K.C. Remon tag in S. side P. Pole N 85° W 133.0'  
In C/L Ashly Ave (gravel) running North & South.  
On field division line running East.

L.C.R.C. #5890

Nail & KC Remon. tag S. side P. Pole N85°W 132.90' (m. 132.08')  
Top C/L S. end 12" CMP culv. N75°E 19.45'  
Top C/L N. end 12" CMP culv. N25°E 34.78'  
SW cor. conc. blk. shed N35°E 709.42'  
NW cor. gar. Fdn. (hse. #7542) S20°E 402.90'

The selected location is accepted by me and is generally accepted by professional surveyors as the best available evidence of the position of the original corner.


C. Description of monument for corner and accessories established to perpetuate locating the position of the corner:

K-3 Standard Kent County Monument

Nail & K.C. remon. tag on S side P. pole N 85° W 132.08'  
Top C/L S end 12" CMP culv. N 75° E 19.45'  
Top C/L N end 12" CMP culv. N 25° E 34.78'  
SW cor. conc. block shed N 35° E 709.42'  
NW cor. garage fndn. hse. #7542 S 20° E 402.90'  
On C/L of gravel road running N-S  
On field division line runing E

P.A. 345 1990 KENT COUNTY

PEER APPROVED 6/25/98  
CHAIRMAN Randy Kolehouse

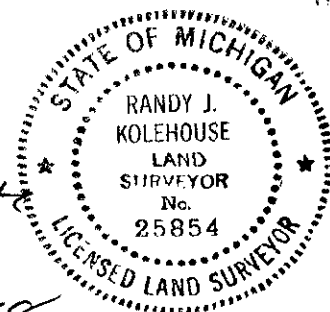

Signed by Randy J. Kolehouse Date 9-1-98

EARTH TECH

Surveyor's Michigan License No. 25854