

**LAND CORNER RECORDATION CERTIFICATE**  
**Filing Requirement of Act 74, Mich. P.A. 1970**  
**KENT COUNTY REMONUMENTATION**

For corners in SECTION  
Kent  
 (County)

Located in: Grattan Township  
 Corner Code # K-4

1. Public Land Survey	T <u>8N</u>	R <u>9W</u>	<u>K-4</u>
	T _____	R _____	_____
	T _____	R _____	_____
	T _____	R _____	_____
2. Property Controlling in Section	S _____	T _____	R _____
	S _____	T _____	R _____
3. Miscellaneous Property in Sec.	S _____	T _____	R _____
	S _____	T _____	R _____

STATE OF MICHIGAN  
 COUNTY OF KENT  
 RECEIVED FOR RECORD


38 OCT 23 AM 10:00

REG. OF DEEDS  
*[Signature]*

**10894**

Register of Deeds Stamp & File Number

4. Lot No. \_\_\_\_\_, Recorded Plat \_\_\_\_\_  
 5. Private Claims \_\_\_\_\_

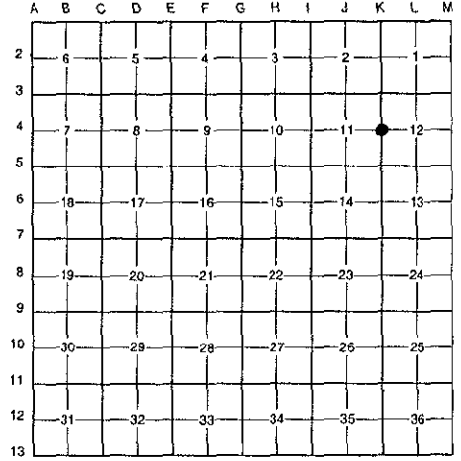

I, Randy Kolehouse, in a field survey on March 3 19 98, do hereby certify that under requirements of P.A. 74 Michigan P.A. of 1970, the corner points mentioned in lines 1 and 2 above were in conformance with regulations and rules therefore as required in the current manual of survey instructions of the United States Department of the interior, Bureau of Land Management or by a decree of a Court of Law and/or that the corner points mentioned in lines 3, 4 and 5 above were in conformance with the rules of the Michigan Board of Land Surveyors or by a Decree of a Court of Law; established, re-established, monumented, re-monumented, recovered, found as expressed below:

**NOTE: Not more than 4 corners, all in the same town and range, may be recorded on this certificate.**

**A. Description of original monument and accessories and/or subsequent restoration:**

K-4	1837	G.L.O. Notes	Cathcart	Set Post
	N/A	Witness Map	K.C. Surveyor	Concrete Monument
	1974	L.C.R.C. #732	Medema, Van Kooten & Assoc.	Set "T" Iron
	1981	L.C.R.C. #2021	Jonker Land Survey	Fnd. "T" Iron / Set K.C. Monument
	1991	L.C.R.C. #5891	William Byl	K.C. Monument

This corner was originally approved by the Kent County Remonumentation Peer Group and monumented by Rob Jonker on 6/16/81 and was recorded per L.C.R.C. #2021.

**B. Description of corner evidence found and/or method applied in restoring or reestablishing corner:**

K-4 Found a Standard Kent County Monument 14' North of the C/L of Strotheide Road (gravel) running East and West and 120' West of the C/L of Ashley Avenue (gravel) running North and South per L.C.R.C.'s #2021 and #5891 as set by Rob Jonker in place of a "T" iron he found which checked L.C.R.C. #732.

L.C.R.C. #2021	L.C.R.C. #5891
Remon. tag on S side 30" Oak N82°W 49.71'	Nail & KC Remon. tag S. side 30" Oak N82°W 49.78'
Remon. tag on N side 16" Hickory S66°W 84.78'	Nail & KC Remon. tag N. side 18" Hickory S66°W 84.84'
Remon. tag on E side 5" Maple N03°W 22.65'	Nail & KC Remon. tag E. side 6" Maple N03°W 22.70'
Remon. tag on S side 8" Elm N65°E 18.94'	Nail & KC Remon. tag S: side 10" Elm N65°E 18.94'
C/L E-W gravel is S. 14' m/l	
C/L N-S gravel is E. 120' m/l	


The selected location is accepted by me and is generally accepted by professional surveyors as the best available evidence of the position of the original corner.

**C. Description of monument for corner and accessories established to perpetuate locating the position of the corner:**

K-4 Standard Kent County Monument

Nail & K.C. remon. tag on S side 30" Oak N 82° W 49.78'  
 Nail & K.C. remon. tag on N side 18" Hickory S 66° W 84.84'  
 Nail & K.C. remon. tag on E side 6" Maple N 03° W 22.70'  
 Nail & K.C. remon. tag on S side 10" dead Elm N 65° E 18.94'  
 Nail & K.C. remon. tag on NW side 12" Elm N 63° E 19.03'  
 C/L of gravel road running E-W, South 14'  
 C/L of gravel road running N-S, East 120'

P.A. 345 1990 KENT COUNTY  
 PEER APPROVED 6/25/98  
 CHAIRMAN *[Signature]*

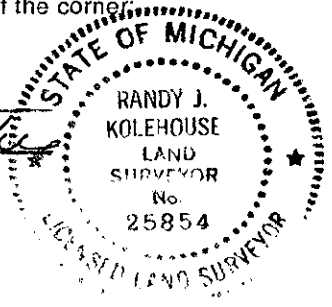

Signed by *[Signature]*  
 EARTH TECH

Date 9-1-98

Surveyor's Michigan License No. 25854