

\$7.00  
\$2.00

MAR 08 1999

SECTION

LAND CORNER RECORDATION CERTIFICATE  
Filing Requirement of Act 74, Mich. P.A. 1970  
KENT COUNTY REMONUMENTATION

For corners in

Kent (County)	Located in: Grattan Township	Corner Code #
1. Public Land Survey	T <u>8N</u> R <u>9W</u>	<u>K-5</u>
	T _____ R _____	_____
	T _____ R _____	_____
	T _____ R _____	_____
2. Property Controlling in Section	S _____ T _____ R _____	_____
	S _____ T _____ R _____	_____
3. Miscellaneous Property in Sec.	S _____ T _____ R _____	_____
	S _____ T _____ R _____	_____

REG. OF DEEDS

*Lucy St. Paul*

38 OCT 23 AM 10:00


STATE OF MICHIGAN  
COUNTY OF KENT  
RECEIVED FOR RECORD

10895

Register of Deeds Stamp & File Number

4. Lot No. \_\_\_\_\_, Recorded Plat \_\_\_\_\_  
5. Private Claims \_\_\_\_\_

I, Randy Kolehouse, in a field survey on February 3 19 98, do hereby certify that under requirements of P.A. 74 Michigan P.A. of 1970, the corner points mentioned in lines 1 and 2 above were in conformance with regulations and rules therefore as required in the current manual of survey instructions of the United States Department of the Interior, Bureau of Land Management or by a decree of a Court of Law and/or that the corner points mentioned in lines 3, 4 and 5 above were in conformance with the rules of the Michigan Board of Land Surveyors or by a Decree of a Court of Law; established, re-established, monumented, re-monumented, recovered, found as expressed below:

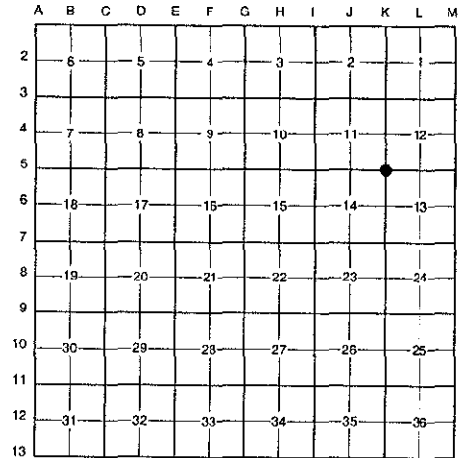

**NOTE:** Not more than 4 corners, all in the same town and range, may be recorded on this certificate.

A. Description of original monument and accessories and/or subsequent restoration:

K-5	1837	G.L.O. Notes	Cathcart	Set Post
	1965	Witness Map	K.C. Surveyor	Concrete Monument
	1976	L.C.R.C. #936	Williams & Works	Concrete Monument
	1981	L.C.R.C. #2022	Jonker Land Survey	Fnd. Plat Monument / Set K.C. Monument
	1991	L.C.R.C. #5892	William Byl	K.C. Monument

This corner was originally approved by the Kent County Remonumentation Peer Group and monumented by Rob Jonker on 6/16/81 and was recorded per L.C.R.C. #2022.

B. Description of corner evidence found and/or method applied in restoring or reestablishing corner:

K-5 Found a Standard Kent County Monument 8' West of the C/L of Ashley Avenue (gravel) running North and South per L.C.R.C.'s #2022 and #5892 as set by Rob Jonker in place of a 4"x12" plat monument he found which checked L.C.R.C. #936 and the K.C. Surveyor's records.

L.C.R.C. #2022

L.C.R.C. #5892

Remon. tag on SW side 8" Hickory S24°E 57.85'  
Remon. tag on E side 12" Basswood S32°W 48.68'  
Remon. tag on N side 10" Tw. Hickory S64°W 36.10'  
Remon. tag on W side 6" Butternut N29°E 70.48'  
"T" iron E 33'  
C/L gravel 8'E

Nail & KC Remon. tag SW side 10" Hickory S24°E 57.83'  
Nail & KC Remon. tag (old nail too far around S. side)  
E. side 14" Basswood S32°W 48.38'  
Nail & KC Remon. tag N. side Tw. 12" Hickory S64°W 36.00'  
Nail & KC Remon. tag W. side 8" Butternut N29°E 70.48'  
"T" Iron N90°E 33.03'


The selected location is accepted by me and is generally accepted by professional surveyors as the best available evidence of the position of the original corner.

C. Description of monument for corner and accessories established to perpetuate locating the position of the corner:

K-5 Standard Kent County Monument

Nail & K.C. remon. tag on SW side 10" Hickory S 24° E 57.83'  
Nail & K.C. remon. tag on E side 14" Basswood S 32° W 48.38'  
Nail & K.C. remon. tag on N side twin 12" Hickory S 64° W 36.00'  
Nail & K.C. remon. tag on W side 8" Butternut N 29° E 70.48'  
"T" iron N 90°E 33.03'  
C/L of gravel road running N-S, East 8'

P.A. 345 1990 KENT COUNTY  
PEER APPROVED 6/25/98  
CHAIRMAN Randy Kolehouse

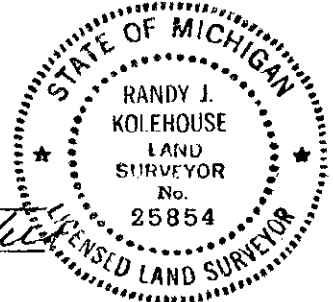

Signed by Randy J. Kolehouse Date 9-1-98

EARTH TECH

Surveyor's Michigan License No. 25854