

MAR 08 1999

\$7.00  
\$2.00

SECTION

**LAND CORNER RECORDATION CERTIFICATE**  
Filing Requirement of Act 74, Mich. P.A. 1970  
KENT COUNTY REMONUMENTATION

STATE OF MICHIGAN  
COUNTY OF KENT  
RECEIVED FOR RECORD  
38 DEC 14 AM 8:00  
REG. OF DEEDS  
*Lucy Stand*

For corners in Kent (County) Located in: Grattan Township Corner Code #

1. Public Land Survey	T <u>8N</u>	R <u>9W</u>	<u>K-6</u>
	T _____	R _____	_____
	T _____	R _____	_____
	T _____	R _____	_____
2. Property Controlling in Section	S _____	T _____	R _____
	S _____	T _____	R _____
3. Miscellaneous Property in Sec.	S _____	T _____	R _____
	S _____	T _____	R _____


4. Lot No. \_\_\_\_\_, Recorded Plat \_\_\_\_\_

5. Private Claims \_\_\_\_\_

10996

Register of Deeds Stamp & File Number

I, Randy Kolehouse, in a field survey on February 4 19 98, do hereby certify that under requirements of P.A. 74 Michigan P.A. of 1970, the corner points mentioned in lines 1 and 2 above were in conformance with regulations and rules therefore as required in the current manual of survey instructions of the United States Department of the interior, Bureau of Land Management or by a decree of a Court of Law and/or that the corner points mentioned in lines 3, 4 and 5 above were in conformance with the rules of the Michigan Board of Land Surveyors or by a Decree of a Court of Law; established, re-established, monumented, re-monumented, recovered, found as expressed below:

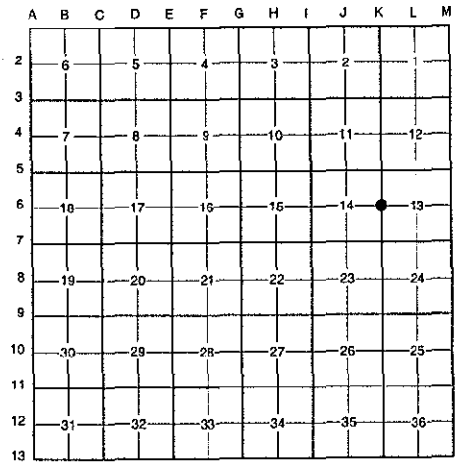

**NOTE:** Not more than 4 corners, all in the same town and range, may be recorded on this certificate.

A. Description of original monument and accessories and/or subsequent restoration:

K-6	1837	G.L.O. Notes	Cathcart	Set Post
	1968	Notes	Williams & Works	P.K. Nail
	1976	L.C.R.C. #936	Williams & Works	P.K. Nail
	1985	L.C.R.C. #4186	R. Kolehouse	Set K.C. Monument

P.A. 345 1999 KENT COUNTY  
PEER APPROVED 9/24/98  
CHAIRMAN Randy Kolehouse

This corner was originally approved by the Kent County Remonumentation Peer Group and monumented by Randy Kolehouse on 3/16/85 and was recorded per L.C.R.C. #4186.

B. Description of corner evidence found and/or method applied in restoring or reestablishing corner:

K-6 Monument destroyed during road construction. Set a temporary point on the C/L of Ashley Avenue (bit.) running North and South using three remaining witnesses from L.C.R.C. #4186. Measure North 2631.34' to the Northwest corner of Section 13. Record per Williams & Works notes and L.C.R.C. #4186 is 2632.23' to a point at the midpoint. Measure mile at 5261.60'. 1/2 = 2630.8'. Point reset is 0.5' ± from midpoint. Accepted location.


L.C.R.C. #4186

- Nail & K.C. Remon. tag in E. side 12" Willow N 40° W 64.50' (m. 64.39')
- C/L East end 7" dia. (m/l) CMP S 85° E 25.2'
- C/L West end 7" dia. (m/l) CMP S 85° W 27.0'

The selected location is accepted by me and is generally accepted by professional surveyors as the best available evidence of the position of the original corner.

C. Description of monument for corner and accessories established to perpetuate locating the position of the corner:

- K-6 Reset a Standard Kent County Monument
- Nail & K.C. remon. tag on E side 16" Willow N 40° W 64.39'
  - Nail & K.C. remon. tag on SW side 6" Poplar S 40° E 32.73'
  - Nail & K.C. remon. tag on W side triple 4" Box Elder N 20° E 94.78'
  - E. face 8" PVC pipe (vert.) West 21.75'
  - C/L E end 7" dia. CMP S 85° E 25.20'
  - C/L W end 7" dia. CMP S 85° W 27.00'
  - On C/L of bit. road running N-S

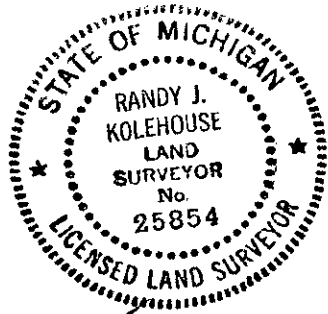

Signed by Randy J. Kolehouse Date 9-30-98

Surveyor's Michigan License No. 25854