

SURVEY & REMONUMENTATION

\$7.00
\$2.00

MAR 08 1999

LAND CORNER RECORDATION CERTIFICATE
Filing Requirement of Act 74, Mich. P.A. 1970
KENT COUNTY REMONUMENTATION

For corners in

SECTION

Kent (County)	Located in:	Grattan Township	Corner Code #
1. Public Land Survey	T <u>8N</u>	R <u>9W</u>	<u>K-7</u>
	T _____	R _____	_____
	T _____	R _____	_____
	T _____	R _____	_____
2. Property Controlling in Section	S _____	T _____	R _____
	S _____	T _____	R _____
3. Miscellaneous Property in Sec.	S _____	T _____	R _____
	S _____	T _____	R _____

STATE OF MICHIGAN
COUNTY OF KENT
RECEIVED FOR RECORD


38 OCT 23 AM 10:00

REG. OF DEEDS

Lucy Bond

10896
Register of Deeds Stamp & File Number

4. Lot No. _____, Recorded Plat _____
5. Private Claims _____

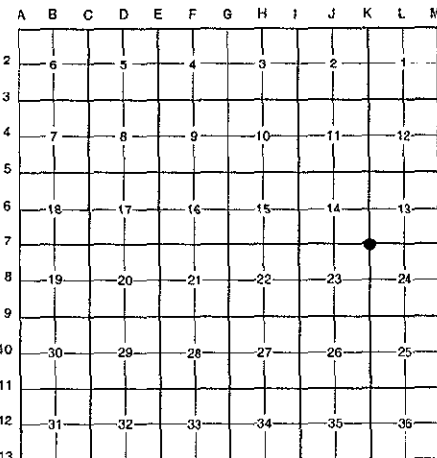

I, Randy Kolehouse, in a field survey on February 4 19 98, do hereby certify that under requirements of P.A. 74 Michigan P.A. of 1970, the corner points mentioned in lines 1 and 2 above were in conformance with regulations and rules therefore as required in the current manual of survey instructions of the United States Department of the interior, Bureau of Land Management or by a decree of a Court of Law and/or that the corner points mentioned in lines 3, 4 and 5 above were in conformance with the rules of the Michigan Board of Land Surveyors or by a Decree of a Court of Law; established, re-established, monumented, re-monumented, recovered, found as expressed below:

NOTE: Not more than 4 corners, all in the same town and range, may be recorded on this certificate.

A. Description of original monument and accessories and/or subsequent restoration:

K-7	1837	G.L.O. Notes	Cathcart	Set Post
	1939-65	Witness Map	K.C. Surveyor	1" Iron
	1978	L.C.R.C. #3562	Medema, Van Kooten & Assoc.	1" Iron
	1983	L.C.R.C. #3644	John Bueche	Fnd. 3/4" Iron / Set K.C. Monument
	1990	L.C.R.C. #5893	William Byl	K.C. Monument

This corner was originally approved by the Kent County Remonumentation Peer Group and monumented by John Bueche on 11/16/83 and was recorded per L.C.R.C. #3644.

B. Description of corner evidence found and/or method applied in restoring or reestablishing corner:

K-7 Found a Standard Kent County Monument at the C/L intersection of Ashley Avenue (gravel) running North and South and 7 Mile Road (gravel) running East and West per L.C.R.C.'s #3644 and #5893 as set by John Bueche in place of a 3/4"x18" iron he found which checked L.C.R.C. #3562 and the K.C. Surveyor's records.

L.C.R.C. #3644

L.C.R.C. #5893

K.C. Remon. tag & nail in S side of 18" Hickory N 80° E 93.47'
K.C. Remon. tag & nail in NW side of 8" Elm N 30° E 66.95'
K.C. Remon. tag & nail in E side of 18" Hickory N 15° W 90.15'
K.C. Remon. tag & nail in S side of 20" Hickory N 75° W 94.75'
Nail in N side of 30" Oak S 80° W 78.10'
On C/L gravel road N - S, E - W

KC Remon. tag & nail S. side 24" Hickory N80°E 93.49'
KC Remon. tag & nail NW side 12" Elm N30°E 66.87'
KC Remon. tag & nail E. side 22" Hickory N15°W 90.20'
KC Remon. tag & nail S. side 24" Hickory N75°W 94.75'
KC Remon. tag & nail NW side 12" Elm S25°W 77.81'
KC Remon. tag & nail N. side 30" Oak S80°W 78.05'


The selected location is accepted by me and is generally accepted by professional surveyors as the best available evidence of the position of the original corner.

C. Description of monument for corner and accessories established to perpetuate locating the position of the corner:

K-7 Standard Kent County Monument

Nail & K.C. remon. tag on S side 24" Hickory N 80° E 93.49'
Nail & K.C. remon. tag on NW side 12" Elm N 30° E 66.87'
Nail & K.C. remon. tag on E side 22" Hickory N 15° W 90.20'
Nail & K.C. remon. tag on S side 24" Hickory N 75° W 94.75'
Nail & K.C. remon. tag on NW side 12" Elm S 25° W 77.81'
Nail & K.C. remon. tag on N side 30" Oak S 80° W 78.05'
On C/L "X" of gravel roads running N-S & E-W

P.A. 345 1990 KENT COUNTY
PEER APPROVED 6/25/98
CHAIRMAN Thompson

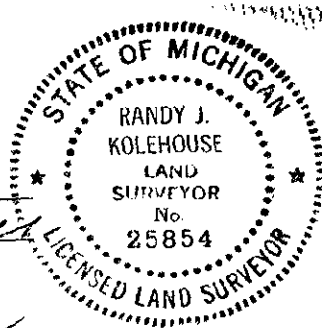

Signed by Randy J. Kolehouse Date 9-1-98
EARTH TECH

Surveyor's Michigan License No. 25854