

SURVEY & REMONUMENTATION
 \$7.00
 \$2.00
 MAR 08 1999

LAND CORNER RECORDATION CERTIFICATE
 Filing Requirement of Act 74, Mich. P.A. 1970
 KENT COUNTY REMONUMENTATION

For corners in **SECTION**


Kent (County)	Located in:	Grattan Township	Corner Code #
1. Public Land Survey	T <u>8N</u>	R <u>9W</u>	<u>K-8</u>
	T _____	R _____	_____
	T _____	R _____	_____
	T _____	R _____	_____
2. Property Controlling in Section	S _____	T _____	R _____
	S _____	T _____	R _____
3. Miscellaneous Property in Sec.	S _____	T _____	R _____
	S _____	T _____	R _____

STATE OF MICHIGAN
 COUNTY OF KENT
 RECEIVED FOR RECORD
 38 OCT 23 AM 10:00
 REG. OF DEEDS
Lucy Storch
 10897

Register of Deeds Stamp & File Number

4. Lot No. _____, Recorded Plat _____
 5. Private Claims _____

I, Randy Kolehouse, in a field survey on February 4 19 98, do hereby certify that under requirements of P.A. 74 Michigan P.A. of 1970, the corner points mentioned in lines 1 and 2 above were in conformance with regulations and rules therefore as required in the current manual of survey instructions of the United States Department of the interior, Bureau of Land Management or by a decree of a Court of Law and/or that the corner points mentioned in lines 3, 4 and 5 above were in conformance with the rules of the Michigan Board of Land Surveyors or by a Decree of a Court of Law; established, re-established, monumented, re-monumented, recovered, found as expressed below:

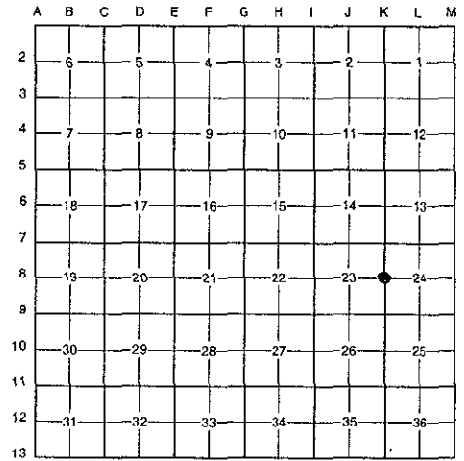

NOTE: Not more than 4 corners, all in the same town and range, may be recorded on this certificate.

A. Description of original monument and accessories and/or subsequent restoration:

K-8	1837	G.L.O. Notes	Cathcart	Set Post
	1983	L.C.R.C. #3448	Jonker Land Survey	1/2" Rerod
	1978	L.C.R.C. #3562	Medema, Van Kooten & Assoc.	1/2" Rod
	1991	L.C.R.C. #5751	K. Roosien	Fnd. Rerod / Set K.C. Monument

This corner was originally approved by the Kent County Remonumentation Peer Group and monumented by K. Roosien in December of 1990 and was recorded per L.C.R.C. #5751.

B. Description of corner evidence found and/or method applied in restoring or reestablishing corner:

K-8 Found a Standard Kent County Monument 38' North of the C/L intersection of Ashley Avenue (gravel) running North and South and South Slayton Lake Drive (gravel) running West, on line of a fence line running West and a tree row and fence line running East, per L.C.R.C. 5751 as set by Kevin Roosien in place of a rerod he found which checked L.C.R.C.'s #3562 and #3448.

L.C.R.C. #5751


- Face of concrete post West 26.19' (m. 26.28')
- Face of 6" MBT box S60°W 31.14' (m. 31.30')
- Nail in k.c. tag in N. side of 14" W. Cherry East 42.96'
- Nail in k.c. tag in W. side of 36" Maple S25°E 73.83'
- Nail in k.c. tag in W. side of 28" Oak S20°W 69.23'

P.A. 345 1990 KENT COUNTY
 PEER APPROVED 6/25/99
 CHAIRMAN *Harry Huber*

The selected location is accepted by me and is generally accepted by professional surveyors as the best available evidence of the position of the original corner.

C. Description of monument for corner and accessories established to perpetuate locating the position of the corner:

- K-8 Standard Kent County Monument
- Face of concrete post West 26.28'
 - Face of MBT box S 60° W 31.30'
 - Nail & K.C. remon. tag on N side of 14" W. Cherry East 42.96'
 - Nail & K.C. remon. tag on W side 36" Maple S 25° E 73.83'
 - Nail & K.C. remon. tag on W side 28" Oak S 20° W 69.23'
 - Face of RR rail fence cor. post East 27.20'
 - C/L "X" of gravel roads running N-S-W, South 38'
 - On fence line running W
 - On tree row and fence line running East

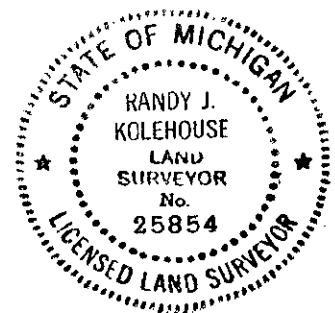

Signed by Randy J. Kolehouse Date 9-1-98

Surveyor's Michigan License No. 25854