

REMONUMENTATION

\$7.00  
\$2.00  
FEB 08 1999

**LAND CORNER RECORDATION CERTIFICATE**  
**Filing Requirement of Act 74, Mich. P.A. 1970**  
**KENT COUNTY REMONUMENTATION**

STATE OF MICHIGAN  
 COUNTY OF KENT  
 RECEIVED FOR RECORD  
 98 OCT 23 AM 10:00  
 REG. OF DEEDS  
*Lucy Sand*

For corners in SECTION


Kent (County)	Located in:	Grattan Township	Corner Code #
1. Public Land Survey	T <u>8N</u>	R <u>9W</u>	<u>K-9</u>
	T _____	R _____	_____
	T _____	R _____	_____
	T _____	R _____	_____
2. Property Controlling in Section	S _____	T _____	R _____
	S _____	T _____	R _____
3. Miscellaneous Property in Sec.	S _____	T _____	R _____
	S _____	T _____	R _____

10898

Register of Deeds Stamp & File Number

4. Lot No. \_\_\_\_\_, Recorded Plat \_\_\_\_\_  
 5. Private Claims \_\_\_\_\_

I, Randy Kolehouse, in a field survey on February 4 19 98, do hereby certify that under requirements of P.A. 74 Michigan P.A. of 1970, the corner points mentioned in lines 1 and 2 above were in conformance with regulations and rules therefore as required in the current manual of survey instructions of the United States Department of the interior, Bureau of Land Management or by a decree of a Court of Law and/or that the corner points mentioned in lines 3, 4 and 5 above were in conformance with the rules of the Michigan Board of Land Surveyors or by a Decree of a Court of Law; established, re-established, monumented, re-monumented, recovered, found as expressed below:

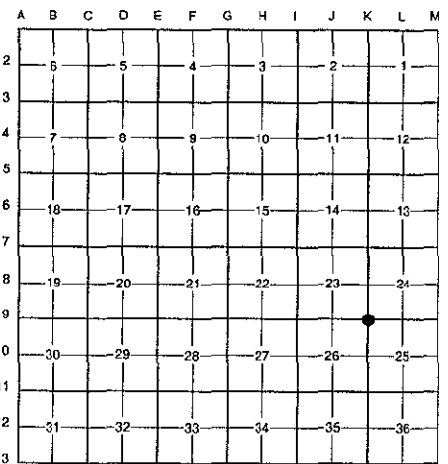

NOTE: Not more than 4 corners, all in the same town and range, may be recorded on this certificate.

A. Description of original monument and accessories and/or subsequent restoration:

K-9	1837	G.L.O. Notes	Cathcart	Set Post
	1965	Witness Map	K.C. Surveyor	Iron
	1983	L.C.R.C. #3448	Jonker Land Survey	1/2" Rerod
	1991	L.C.R.C. #5751	Kevin Roosien	Fnd. Rerod / Set K.C. Monument

This corner was originally approved by the Kent County Remonumentation Peer Group and monumented by K. Roosien in December of 1990 and was recorded per L.C.R.C. #5751.

B. Description of corner evidence found and/or method applied in restoring or reestablishing corner:

K-9 Found a Standard Kent County Monument at the C/L intersection of 6 Mile Road (bit.) running East and West and Ashley Avenue (gravel) running North and South per L.C.R.C. #5751 as set by Kevin Roosien in place of a rerod he found over a 1" iron which checked L.C.R.C. #3448 and the K.C. Surveyor's records.

L.C.R.C. #5751


- Nail in k.c. tag in S. side p. pole N70°E 88.10'
- Nail in k.c. tag in W. side t. pole S15°E 77.55'
- Nail in k.c. tag in NW side 10" Ash S25°W 102.98' (m. 102.86')

P.A. 345 1990 KENT COUNTY  
 PEER APPROVED 6/25/98  
 CHAIRMAN *Randy Kolehouse*

The selected location is accepted by me and is generally accepted by professional surveyors as the best available evidence of the position of the original corner.

C. Description of monument for corner and accessories established to perpetuate locating the position of the corner:

- K-9 Standard Kent County Monument
- Nail & K.C. remon. tag on S side P. pole N 70° E 88.10'
  - Nail & K.C. remon. tag on W side sawed off T. pole S 15° E 77.55'
  - Nail & K.C. remon. tag on NW side 10" Ash S 25° W 102.86'
  - Nail & K.C. remon. tag on S side 18" Hickory N 70° W 139.00'
  - Nail & K.C. remon. tag on SW side twin 8" Willow S 40° E 71.50'
  - On C/L "X" of bit. road running E-W and gravel road running N-S

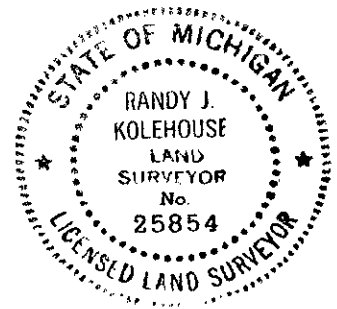

Signed by *Randy J. Kolehouse*  
 EARTH TECH

Date 9-1-98

Surveyor's Michigan License No. 25854