

SURVEY & REMONUMENTATION

 \$7.00 / \$2.00

 MAR 9 8 1989

LAND CORNER RECORDATION CERTIFICATE
Filing Requirement of Act 74, Mich. P.A. 1970
KENT COUNTY REMONUMENTATION

For corners in SECTION
Kent
 (County)

Located in:	Grattan Township	Corner Code #
1. Public Land Survey	T <u>8N</u> R <u>9W</u>	<u>K-11</u>
	T _____ R _____	_____
	T _____ R _____	_____
	T _____ R _____	_____
2. Property Controlling in Section	S _____ T _____ R _____	_____
	S _____ T _____ R _____	_____
3. Miscellaneous Property in Sec.	S _____ T _____ R _____	_____
	S _____ T _____ R _____	_____

STATE OF MICHIGAN
 COUNTY OF KENT
 RECEIVED FOR RECORD
 98 DEC 14 AM 8:00
 REG. OF DEEDS
Lucy Standa
10998
 Register of Deeds Stamp & File Number


4. Lot No. _____, Recorded Plat _____
 5. Private Claims _____

I, Randy Kolehouse, in a field survey on February 5 19 98, do hereby certify that under requirements of P.A. 74 Michigan P.A. of 1970, the corner points mentioned in lines 1 and 2 above were in conformance with regulations and rules therefore as required in the current manual of survey instructions of the United States Department of the Interior, Bureau of Land Management or by a decree of a Court of Law and/or that the corner points mentioned in lines 3, 4 and 5 above were in conformance with the rules of the Michigan Board of Land Surveyors or by a Decree of a Court of Law; established, re-established, monumented, re-monumented, recovered, found as expressed below:

NOTE: Not more than 4 corners, all in the same town and range, may be recorded on this certificate.

A. Description of original monument and accessories and/or subsequent restoration:

K-11	1837	G.L.O. Notes	Calhcart	Set Post
	1932	Witness Map	K.C. Surveyor	1" Iron & Stone
	1984	L.C.R.C. #3791	R. Kolehouse	Fnd. 1" Iron / Set K.C. Monument
	1990	L.C.R.C. #5895	William Byl	K.C. Monument

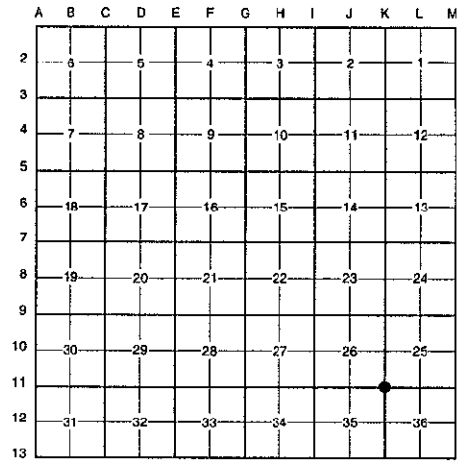

P.A. 345 1990 KENT COUNTY
 PEER APPROVED 9/24/98
 CHAIRMAN *Randy Kolehouse*

This corner was originally approved by the Kent County Remonumentation Peer Group and monumented by Randy Kolehouse in February of 1984 and was recorded per L.C.R.C. #3791.

B. Description of corner evidence found and/or method applied in restoring or reestablishing corner:

K-11 Found a Standard Kent County Monument 7' North of the C/L of 5 Mile Road (gravel) running East and West, 2' West of the C/L of Ashley Avenue (gravel) running North, and 2.5' East of the C/L of Ashley Avenue (gravel) running South per L.C.R.C.'s #3791 and #5895 as set by Randy Kolehouse in place of a 1" iron he found which checked the K.C. Surveyor's records.

L.C.R.C. #3791	L.C.R.C. #5895
Nail & K.C. Remon tag in S. side twin 18" Walnut N 60 W 76.30'	Nail & KC Remon. tag S. side Tw. 24" Walnut N60°W 76.34'
Nail & K.C. Remon tag in N. side 48" Oak S 65 W 74.70'	Nail & KC Remon. tag N. side 52" Oak S65°W 74.72' (m. 74.75')
Nail & K.C. Remon tag in SE side 10" Maple S 45 W 48.70'	Nail & KC Remon. tag W. side 48" Oak S15°E 80.99'
Nail & K.C. Remon tag in W. side 44" Oak S 15 E 80.95'	C/L Grav. Rd. South - East 6'
	C/L Grav. Rd. North - West 5'
	C/L E-W Grav. Rd. - South 5'

The selected location is accepted by me and is generally accepted by professional surveyors as the best available evidence of the position of the original corner.

C. Description of monument for corner and accessories established to perpetuate locating the position of the corner:

K-11 Standard Kent County Monument

Nail & K.C. remon. tag on S side twin 24" Walnut N 60° W 76.34'
 Nail & K.C. remon. tag on N side 52" Oak S 65° W 74.75'
 Nail & K.C. remon. tag on W side 48" Oak S 15° E 80.99'
 Nail & K.C. remon. tag on SE side 14" Oak S 45° W 48.79'
 C/L gravel road running S, West 2.5'
 C/L gravel road running N, East 2'
 C/L gravel road running E-W, South 7'



Signed by *Randy J. Kolehouse* Date 9-30-98
 EARTH TECH
 Surveyor's Michigan License No. 25854