SURVEY & REMONUMENTATION

$7.00
$2.00

MAR 0 8 1999

SECTION

LAND CORNER RECORDATION CERTIFICATE

Filing Requirement of Act 74, Mich. P.A. 1970

KENT COUNTY REMONUMENTATION

STATE OF MICHIGAN
COUNTY OF KENT
RECEIVED FOR RECORD
98 DEC 14 AM 8:00
REG. OF DEEDS

11001

Register of Deeds Stamp & File Number

For corners in Kent (County) Located in: Grattan Township Corner Code #

1. Public Land Survey T 8N R 9W L-1
   T ___ R ___
   T ___ R ___
   T ___ R ___
2. Property Controlling in Section S ___ T ___ R ___
   S ___ T ___ R ___
3. Miscellaneous Property in Sec. S ___ T ___ R ___
   S ___ T ___ R ___

4. Lot No. ___, Recorded Plat ___
5. Private Claims ___

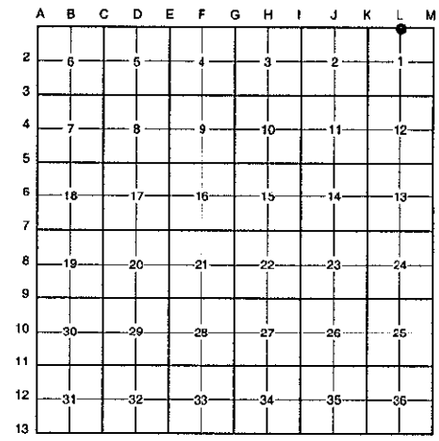

I, Randy Kolehouse, in a field survey on January 28 19 98, do hereby certify that under requirements of P.A. 74 Michigan P.A. of 1970, the corner points mentioned in lines 1 and 2 above were in conformance with regulations and rules therefore as required in the current manual of survey instructions of the United States Department of the interior, Bureau of Land Management or by a decree of a Court of Law and/or that the corner points mentioned in lines 3, 4 and 5 above were in conformance with the rules of the Michigan Board of Land Surveyors or by a Decree of a Court of Law; established, re-established, monumented, re-monumented, recovered, found as expressed below:

NOTE: Not more than 4 corners, all in the same town and range, may be recorded on this certificate.

A. Description of original monument and accessories and/or subsequent restoration:

L-1 This corner was not originally set by the G.L.O.

1985	L.C.R.C. #4272	William Byl	Set K.C. Monument
1994	L.C.R.C. #7248	Glaza & Associates	K.C. Monument

P.A. 345 1990 KENT COUNTY
PEER APPROVED 9/24/98
CHAIRMAN [signature]

Note: This corner is not common with L-13, T9N, R9W.

This corner was originally approved by the Kent County Remonumentation Peer Group and monumented by William Byl on 7/1/85 and was recorded per L.C.R.C. #7248.

B. Description of corner evidence found and/or method applied in restoring or reestablishing corner:

L-1 Found a Standard Kent County Monument on the C/L of 10 Mile Road (gravel) running East and West (10" below grade), on line of a tree row running South, per L.C.R.C.'s #4272 and #7248 as set by William Byl midway between the Northeast and Northwest corners of Section 1 and on the South line of Section 36.

L.C.R.C. #4272	L.C.R.C. #7248
Nail & tag, E sd. Power pole N 05 E 61.92'	Nail & K.C. remon tag in E side P. pole N05°E 61.92' (m. 61.91')
Nail & tag, W sd. Power pole S 05 W 39.92'	Nail & K.C. remon tag in W side P. pole S05°W 39.98'
Nail & tag, W sd. 24" Oak N 25 E 53.99'	Nail & K.C. remon tag in W side 24" Oak N25°E 53.99' (m. 53.96')
Nail & tag, E sd. 24" Maple N 50 W 59.26'	Nail & K.C. remon tag in NE side 24" Maple N50°W 59.26' (m. 59.29')
Nail & tag, N sd. 36" Maple S 80 W 119.83'	Nail & K.C. remon tag in N side 36" Maple S80°W 119.83' (m. 115.87')
NW cor. fdn. Hse #14010 S 10 E 113.84'	NW corner foundation of house $14010 S10°E 113.84' (m. 113.87')
	Kent Co Mon @ S 1/4 cor, Sec 36, T9N, R9W, N90°E 34.98' (m. 34.97')
	In C/L E-W gravel road

The selected location is accepted by me and is generally accepted by professional surveyors as the best available evidence of the position of the original corner.

C. Description of monument for corner and accessories established to perpetuate locating the position of the corner:

L-1 Standard Kent County Monument

Nail & K.C. remon. tag on E side P. pole N 05° E 61.91'
Nail & K.C. remon. tag on W side P. pole S 05° W 39.98'
Nail & K.C. remon. tag on W side 24" Oak N 25° E 53.96'
Nail & K.C. remon. tag on N side 36" Maple S 80° W 119.84'
Nail & K.C. remon. tag on NE side 28" Maple N 50° W 59.29'

NW cor. foundation of house #14010 S 10° E 113.87'
On C/L of gravel road running E-W
On tree row running South
K.C. Mon., L-13, T9N, R9W, N 90° E 34.97'

Signed by Randy J. Kolehouse Date 9-30-98
EARTH TECH

STATE OF MICHIGAN
RANDY J. KOLEHOUSE
LAND SURVEYOR
No. 25854
LICENSED LAND SURVEYOR

Surveyor's Michigan License No. 25854

FORM APPROVED BY MICHIGAN STATE BOARD OF LAND SURVEYORS, JAN. 28, 1971
REVISED MAY 14, 1975
REVISED JAN., 1983