

MAR 08 1999

\$7.00
\$2.00

SECTION

LAND CORNER RECORDATION CERTIFICATE
Filing Requirement of Act 74, Mich. P.A. 1970
KENT COUNTY REMONUMENTATION

For corners in

Kent (County)	Located in:	Grattan Township	Corner Code #
1. Public Land Survey	T <u>8N</u>	R <u>9W</u>	<u>L-3</u>
	T _____	R _____	_____
	T _____	R _____	_____
	T _____	R _____	_____
2. Property Controlling in Section	S _____	T _____	R _____
	S _____	T _____	R _____
3. Miscellaneous Property in Sec.	S _____	T _____	R _____
	S _____	T _____	R _____
4. Lot No. _____, Recorded Plat _____			
5. Private Claims _____			

STATE OF MICHIGAN
COUNTY OF KENT
RECEIVED FOR RECORD
98 OCT 23 AM 10:00
REG. OF DEEDS
David Bond

10899
Register of Deeds Stamp & File Number


I, Randy Kolehouse, in a field survey on February 20 19 98, do hereby certify that under requirements of P.A. 74 Michigan P.A. of 1970, the corner points mentioned in lines 1 and 2 above were in conformance with regulations and rules therefore as required in the current manual of survey instructions of the United States Department of the interior, Bureau of Land Management or by a decree of a Court of Law and/or that the corner points mentioned in lines 3, 4 and 5 above were in conformance with the rules of the Michigan Board of Land Surveyors or by a Decree of a Court of Law; established, re-established, monumented, re-monumented, recovered, found as expressed below:

NOTE: Not more than 4 corners, all in the same town and range, may be recorded on this certificate.

A. Description of original monument and accessories and/or subsequent restoration:

L-3	1837	G.L.O. Notes	Cathcart	Set Post
	1985	L.C.R.C. #4301	R. Kolehouse	Fnd. Pointed Stone / Set K.C. Monument
	1991	L.C.R.C. #5898	William Byl	K.C. Monument

P.A. 345 1990 KENT COUNTY
PEER APPROVED 6/29/98
CHAIRMAN Randy Kolehouse

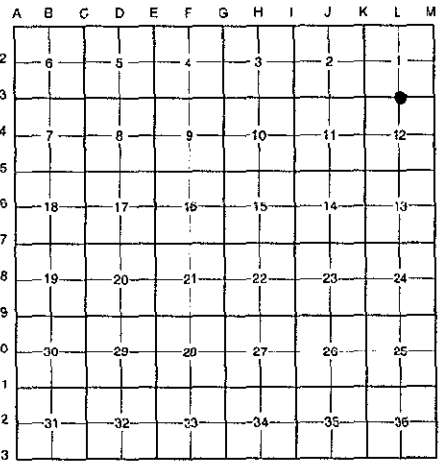

This corner was originally approved by the Kent County Remonumentation Peer Group and monumented by Randy Kolehouse on 8/10/85 and was recorded per L.C.R.C. #4301.

B. Description of corner evidence found and/or method applied in restoring or reestablishing corner:

L-3 Found a Standard Kent County Monument on line of a tree row running South and East per L.C.R.C.'s #4301 and #5898 as set by Randy Kolehouse in place of a small 4"x10"x14" pointed stone.

L.C.R.C. #4301

L.C.R.C. #5898

Nail & K.C. Remon. tag in W. side 10" Hickory South 18.10'
Nail & K.C. Remon. tag in NE side 12" Hickory S 45° E 25.38'
Nail & K.C. Remon. tag in N. side 14" Ash S 60° E 10.85'
Nail & K.C. Remon. tag in S. side 12" W. Cherry S 85° E 31.85'
On line of fences running East & South


Nail & KC Remon. tag W. side 10" Hickory S00°W 18.10' (m. 18.12')
Nail & KC Remon. tag NE side 12" Hickory S45°E 25.35'
Nail & KC Remon. tag N. side 16" Ash S60°E 10.82'
Nail & KC Remon. tag S: side 12" W. Cherry S85°E 31.85' (m. 31.83')

The selected location is accepted by me and is generally accepted by professional surveyors as the best available evidence of the position of the original corner.

C. Description of monument for corner and accessories established to perpetuate locating the position of the corner:

L-3 Standard Kent County Monument

Nail & K.C. remon. tag on W side 10" Hickory S 00° W 18.12'
Nail & K.C. remon. tag on NE side 12" Hickory S 45° E 25.35'
Nail & K.C. remon. tag on N side 16" Ash S 60° E 10.82'
Nail & K.C. remon. tag on S side 10" W. Cherry S 85° E 31.83'
On tree row running S & E

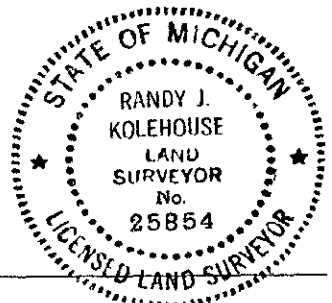

Signed by Randy J. Kolehouse Date 9-1-98

EARTH TECH

Surveyor's Michigan License No. 25854