

\$7.00  
\$2.00

MAR 08 1999

REG. OF DEEDS

*Lucy Bond*

38 DEC 14 AM 8:00

STATE OF MICHIGAN  
COUNTY OF KENT  
RECEIVED FOR RECORD

SECTION

LAND CORNER RECORDATION CERTIFICATE  
Filing Requirement of Act 74, Mich. P.A. 1970  
KENT COUNTY REMONUMENTATION


For corners in

| Kent<br>(County)                      | Located in: | Grattan<br>Township | Corner Code # |
|---------------------------------------|-------------|---------------------|---------------|
| 1. Public Land Survey                 | T <u>8N</u> | R <u>9W</u>         | <u>L-4</u>    |
|                                       | T _____     | R _____             | _____         |
|                                       | T _____     | R _____             | _____         |
|                                       | T _____     | R _____             | _____         |
| 2. Property Controlling<br>in Section | S _____     | T _____             | R _____       |
|                                       | S _____     | T _____             | R _____       |
| 3. Miscellaneous<br>Property in Sec.  | S _____     | T _____             | R _____       |
|                                       | S _____     | T _____             | R _____       |

11054  
Register of Deeds Stamp & File Number

- 4. Lot No. \_\_\_\_\_, Recorded Plat \_\_\_\_\_
- 5. Private Claims \_\_\_\_\_

I, Randy Kolehouse, in a field survey on October 28 19 98, do hereby certify that under requirements of P.A. 74 Michigan P.A. of 1970, the corner points mentioned in lines 1 and 2 above were in conformance with regulations and rules therefore as required in the current manual of survey instructions of the United States Department of the interior, Bureau of Land Management or by a decree of a Court of Law and/or that the corner points mentioned in lines 3, 4 and 5 above were in conformance with the rules of the Michigan Board of Land Surveyors or by a Decree of a Court of Law; established, re-established, monumented, re-monumented, recovered, found as expressed below:

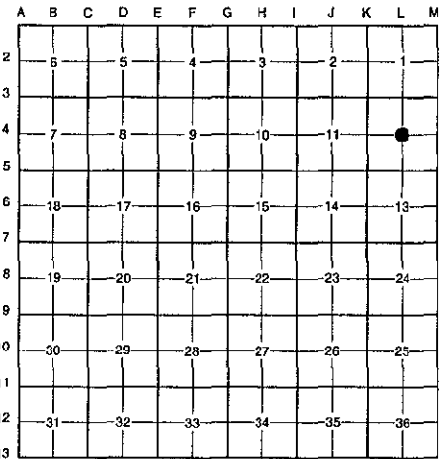

NOTE: Not more than 4 corners, all in the same town and range, may be recorded on this certificate.

A. Description of original monument and accessories and/or subsequent restoration:

- L-4 This corner was not originally set by the G.L.O.  
1935 Witness Map K.C. Surveyor Concrete Monument

P.A. 345 1990 KENT COUNTY  
PEER APPROVED 11/12/98  
CHAIRMAN *[Signature]*

B. Description of corner evidence found and/or method applied in restoring or reestablishing corner:


- L-4 Found a concrete monument with a 1" iron pipe on the South edge of Strotheid Road (gravel) running East and West per the Kent County Surveyor's records. No witnesses remained from 1935 witness map. Concrete monument with iron is 3.0' South and 4.5' West of the intersection of 1/4 lines. Accepted concrete monument as Center of Section.

The selected location is accepted by me and is generally accepted by professional surveyors as the best available evidence of the position of the original corner.

C. Description of monument for corner and accessories established to perpetuate locating the position of the corner:

- L-4 Replaced Concrete Monument and 1" Iron Pipe with a Standard Kent County Monument

- Rebar 1' N of underground gas marker S 80° E 63.58'
- Nail & K.C. remon. tag on N side P. pole S 80° W 159.90'
- Nail & K.C. remon. tag on NE side P. pole S 70° E 179.43'
- "+" cut on E end 12" conc. culvert N 70° E 60.66'
- "+" cut on S end of 24" conc. culvert N 30° E 76.16'

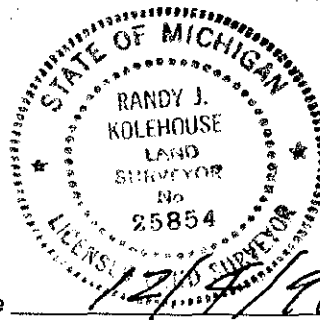

Signed by *Randy J. Kolehouse* Date 11/27/98  
EARTH TECH

Surveyor's Michigan License No. 25854