

**SURVEY & REMONUMENTATION**

\$7.00  
\$2.00

MAR 08 1999

**LAND CORNER RECORDATION CERTIFICATE**  
Filing Requirement of Act 74, Mich. P.A. 1970  
KENT COUNTY REMONUMENTATION

For corners in SECTION

Kent (County)	Located in:	Grattan Township	Corner Code #
1. Public Land Survey	T <u>8N</u>	R <u>9W</u>	<u>L-5</u>
	T _____	R _____	_____
	T _____	R _____	_____
	T _____	R _____	_____
2. Property Controlling in Section	S _____	T _____	R _____
	S _____	T _____	R _____
3. Miscellaneous Property in Sec.	S _____	T _____	R _____
	S _____	T _____	R _____

REG. OF DEEDS

*Lucy Sand*

38 DEC 14 AM 8:00

STATE OF MICHIGAN  
COUNTY OF KENT  
RECEIVED FOR RECORD

11002

Register of Deeds Stamp & File Number


4. Lot No. \_\_\_\_\_, Recorded Plat \_\_\_\_\_  
5. Private Claims \_\_\_\_\_

I, Randy Kolehouse, in a field survey on March 25 19 98, do hereby certify that under requirements of P.A. 74 Michigan P.A. of 1970, the corner points mentioned in lines 1 and 2 above were in conformance with regulations and rules therefore as required in the current manual of survey instructions of the United States Department of the interior, Bureau of Land Management or by a decree of a Court of Law and/or that the corner points mentioned in lines 3, 4 and 5 above were in conformance with the rules of the Michigan Board of Land Surveyors or by a Decree of a Court of Law; established, re-established, monumented, re-monumented, recovered, found as expressed below:

**NOTE: Not more than 4 corners, all in the same town and range, may be recorded on this certificate.**

A. Description of original monument and accessories and/or subsequent restoration:

L-5	1837	G.L.O. Notes	Cathcart	Set Post
	1935	Witness Map	K.C. Surveyor	1" Iron
	1955-68	Notes	Williams & Works	Iron & Stone
	1985	L.C.R.C. #4187	Kolehouse	Fnd. 1" iron & Stones / Set K.C. Monument
	1991	L.C.R.C. #5899	William Byl	K.C. Monument

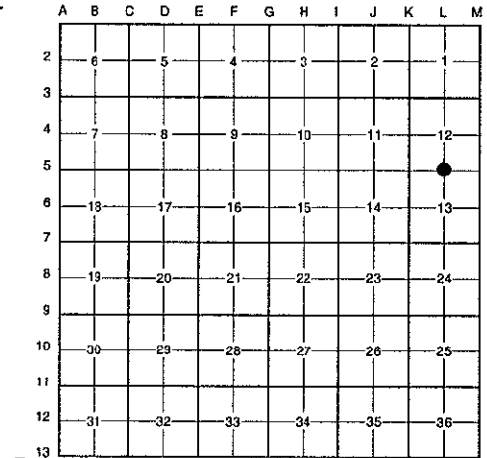

P.A. 345 1990 KENT COUNTY  
PEER APPROVED 9/24/98  
CHAIRMAN Randy Kolehouse

This corner was originally approved by the Kent County Remonumentation Peer Group and monumented by Randy Kolehouse on 4/1/85 and was recorded per L.C.R.C. #4187.

B. Description of corner evidence found and/or method applied in restoring or reestablishing corner:

L-5 Found a Standard Kent County Monument 8" below grade and 125' ± East of East edge of woods running North and South in an open field per L.C.R.C.'s #4187 and #5899 as set by Randy Kolehouse in place of a 1" iron and stones he found which checked the 1955-68 notes of Williams & Works and the K.C. Surveyor's records.

L.C.R.C. #4187

L.C.R.C. #5899


- Nail & K.C. Remon. tag in E. side 22" Hickory N 20° W 179.40'
- Nail & K.C. Remon. tag in S. side tw. 8" W. Cherry N 60° W 226.55'
- Nail & K.C. Remon. tag in S. side 12" Elm S 60° W 146.06'
- Nail & K.C. Remon. tag in E. side 8" Oak S 20° W 185.45'

- Nail & KC Remon. tag E. side 24" Hickory N20°W 179.45' (m. 179.55')
- Nail & KC Remon. tag S. side 3-10" W. Cherry N75°W 226.15' (m. 226.19')
- Nail & KC Remon. tag SE side 12" Oak S20°W 183.70' (m. 183.80')
- Nail & KC Remon. tag SE side Tw. 8" Ash S40°W 161.20' (m. 161.31')

The selected location is accepted by me and is generally accepted by professional surveyors as the best available evidence of the position of the original corner.

C. Description of monument for corner and accessories established to perpetuate locating the position of the corner:

- L-5 Standard Kent County Monument (8" below grade)
- Nail & K.C. remon. tag on S side 3 - 10" Cherries N 75° W 226.19'
  - Nail & K.C. remon. tag on E side 24" Hickory N 20° W 179.55'
  - Nail & K.C. remon. tag on SE side 12" Oak S 20° W 183.80'
  - Nail & K.C. remon. tag on SE side Twin 8" Ash S 40° W 161.31'
  - Tree row running N-S, West 125'

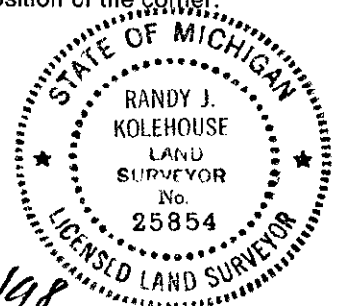

Signed by Randy J. Kolehouse  
EARTH TECH

Date 11/18/98

Surveyor's Michigan License No. 25854