

77.00 / 2.00 SURVEY & REMONUMENTATION
 MAR 08 1999

LAND CORNER RECORDATION CERTIFICATE
Filing Requirement of Act 74, Mich. P.A. 1970
KENT COUNTY REMONUMENTATION

SECTION

For corners in


Kent (County)	Located in:	Grattan Township	Corner Code #
1. Public Land Survey	T <u>8N</u>	R <u>9W</u>	<u>L-7</u>
	T _____	R _____	_____
	T _____	R _____	_____
	T _____	R _____	_____
2. Property Controlling in Section	S _____	T _____	R _____
	S _____	T _____	R _____
3. Miscellaneous Property in Sec.	S _____	T _____	R _____
	S _____	T _____	R _____

STATE OF MICHIGAN
 COUNTY OF KENT
 RECEIVED FOR RECORD
 98 OCT 23 AM 10:00
 REG. OF DEEDS
David Spauld

10900

Register of Deeds Stamp & File Number

4. Lot No. _____, Recorded Plat _____
 5. Private Claims _____

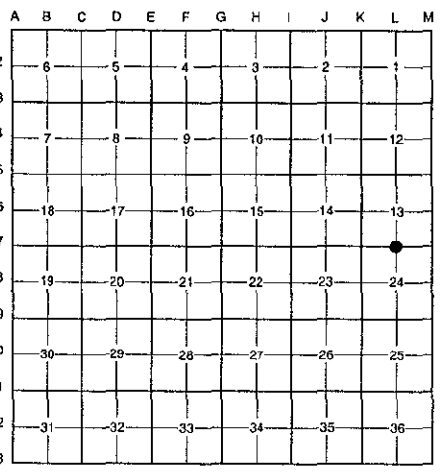

I, Randy Kolehouse, in a field survey on February 3 19 98, do hereby certify that under requirements of P.A. 74 Michigan P.A. of 1970, the corner points mentioned in lines 1 and 2 above were in conformance with regulations and rules therefore as required in the current manual of survey instructions of the United States Department of the interior, Bureau of Land Management or by a decree of a Court of Law and/or that the corner points mentioned in lines 3, 4 and 5 above were in conformance with the rules of the Michigan Board of Land Surveyors or by a Decree of a Court of Law; established, re-established, monumented, re-monumented, recovered, found as expressed below:

NOTE: Not more than 4 corners, all in the same town and range, may be recorded on this certificate.

A. Description of original monument and accessories and/or subsequent restoration:

L-7	1837	G.L.O. Notes	Cathcart	Set Post
	1981	L.C.R.C. #3562	Medema, Van Kooten & Assoc.	"T" Iron
	1983	L.C.R.C. #3645	John Bueche	Fnd. "T" Iron / Set K.C. Monument
	1990	L.C.R.C. #5900	William Byl	K.C. Monument

This corner was originally approved by the Kent County Remonumentation Peer Group and monumented by John Bueche on 11/16/83 and was recorded per L.C.R.C. #3645.

B. Description of corner evidence found and/or method applied in restoring or reestablishing corner:

L-7 Found a Standard Kent County Monument on the C/L of 7 Mile Road (gravel) running East and West, on line of a tree row running South, per L.C.R.C.'s #3645 and #5900 as set by John Bueche in place of a "T" iron he found which checked L.C.R.C. #3562.

L.C.R.C. #3645

L.C.R.C. #5900

- N & J tag & nail in E. side 24" Walnut S 0° W 17.90'
- N & J tag & nail in SE side 34" Hickory N 70° E 69.10'
- K.C. Remon. tag & nail in SW side 14" Hickory S 55° E 33.53'
- K.C. Remon. tag & nail in SW side 14" Hickory N 60° W 58.36'


- Nail & KC Remon. tag E. side 27" Walnut S00°W 17.83' (m. 17.85')
- Nail & KC Remon. tag S. side 36" Hickory N70°E 69.10' (m. 69.03')
- Nail & KC Remon. tag SW side 16" Hickory S55°E 33.53' (m. 33.58')
- Nail & KC Remon. tag SW side 16" Hickory N60°W 58.32' (m. 58.34')

The selected location is accepted by me and is generally accepted by professional surveyors as the best available evidence of the position of the original corner.

C. Description of monument for corner and accessories established to perpetuate locating the position of the corner:

- L-7 Standard Kent County Monument
- Nail & K.C. remon. tag on E side 27" Walnut South 17.85'
 - Nail & K.C. remon. tag on S side 36" Hickory N 70° E 69.03'
 - Nail & K.C. remon. tag on SW side 16" Hickory S 55° E 33.58'
 - Nail & K.C. remon. tag on SW side 18" Hickory N 60° W 58.34'
 - On C/L of gravel road running E-W
 - On tree row running S

P.A. 345 1990 KENT COUNTY
 PEER APPROVED 6/25/98
 CHAIRMAN Barry Huber

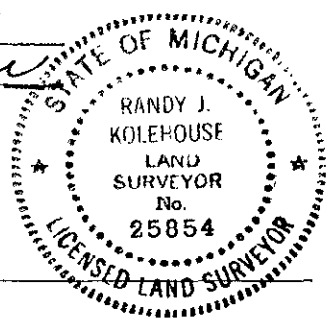

Signed by Randy J. Kolehouse
 EARTH TECH

Date 9-1-98

Surveyor's Michigan License No. 25854