

SURVEY & REMONUMENTATION
 \$7.00
 \$2.00

MAY 22 2000

LAND CORNER RECORDATION CERTIFICATE
Filing Requirement of Act 74, Mich. P.A. 1970
KENT COUNTY REMONUMENTATION

Page 2

REC'D
 1999 DEC 30 AM 9:54
 RECEIVED FOR RECORD
 COUNTY OF KENT
 REGISTER OF DEEDS

For corners in	SECTION	Located in:	Grattan Township	Corner Code #
Kent (County)				
1. Public Land Survey	T 8N R 9W			L-9
	T R			
	T R			
	T R			
2. Property Controlling in Section	S T R			
	S T R			
3. Miscellaneous Property in Sec.	S T R			
	S T R			


REG. OF DEEDS

11689

Register of Deeds Stamp & File Number

- 4. Lot No. _____, Recorded Plat _____
- 5. Private Claims _____

I, Randy Kolehouse, in a field survey on December 29 19 99, do hereby certify that under requirements of P.A. 74 Michigan P.A. of 1970, the corner points mentioned in lines 1 and 2 above were in conformance with regulations and rules therefore as required in the current manual of survey instructions of the United States Department of the interior, Bureau of Land Management or by a decree of a Court of Law and/or that the corner points mentioned in lines 3, 4 and 5 above were in conformance with the rules of the Michigan Board of Land Surveyors or by a Decree of a Court of Law; established, re-established, monumented, re-monumented, recovered, found as expressed below:

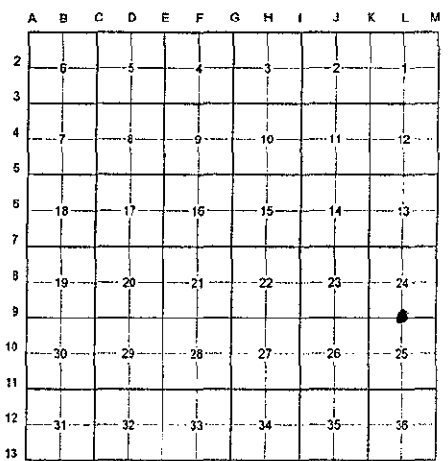

NOTE: Not more than 4 corners, all in the same town and range, may be recorded on this certificate.

A. Description of original monument and accessories and/or subsequent restoration:

L-9	1837	G.L.O. Notes	Cathcart	Set Post
	1983	L.C.R.C. #3649	John Bueche	Set K.C. Monument
	1986	L.C.R.C. #4432	R. Kolehouse	Set Riser Over K.C. Monument
	1991	L.C.R.C. #5901	William Byl	K.C. Monument
	1998	L.C.R.C. #11003	Earth Tech	K.C. Monument

This corner was originally approved by the Kent County Remonumentation Peer Group and monumented by John Bueche on 11/21/83 and was recorded per L.C.R.C. #3649. This corner was remonumented on 2/26/98 by Earth Tech and recorded per L.C.R.C. #11003.

B. Description of corner evidence found and/or method applied in restoring or reestablishing corner:

L-9 Found a Standard Kent County Monument per L.C.R.C. #11003 witnesses as set by Earth Tech.

L.C.R.C. #11003

- Nail & K.C. remon. tag on W side 6" Oak S 00° W 23.07'
- Nail & K.C. remon. tag on SW side 14" Poplar S 55° E 48.63'
- Nail & K.C. remon. tag on SW side 16" Poplar S 70° E 82.52'
- Nail & K.C. remon. tag on S side P. pole N 80° E 122.52'
- Nail & K.C. remon. tag on S side 24" Poplar N 60° W 95.24'
- "X" cut top W end 12" conc. culv. N 50° E 33.72'
- On C/L of bit. road running E-W

P.A. 345 1990 KENT COUNTY
 PEER APPROVED 9/24/99
 CHAIRMAN Henry Huber

The selected location is accepted by me and is generally accepted by professional surveyors as the best available evidence of the position of the original corner.

C. Description of monument for corner and accessories established to perpetuate locating the position of the corner:

L-9 Reset a Standard Kent County Monument - Also Set a Monument Box

- Nail & K.C. remon. tag on W side 6" Oak S 00° W 23.07'
- Nail & K.C. remon. tag on SW side 14" Poplar S 55° E 48.63'
- Nail & K.C. remon. tag on SW side 16" Poplar S 70° E 82.52'
- Nail & K.C. remon. tag on S side P. pole N 80° E 122.52'
- Nail & K.C. remon. tag on S side 24" Poplar N 60° W 95.24'
- "X" cut top W end 12" conc. culv. N 50° E 33.72'
- On C/L of bit. road running E-W



Signed by Randy J. Kolehouse
 WILLIAMS & WORKS

Date 12-29-99

Surveyor's Michigan License No. 25854